


T.1N.R.4W.W.M.

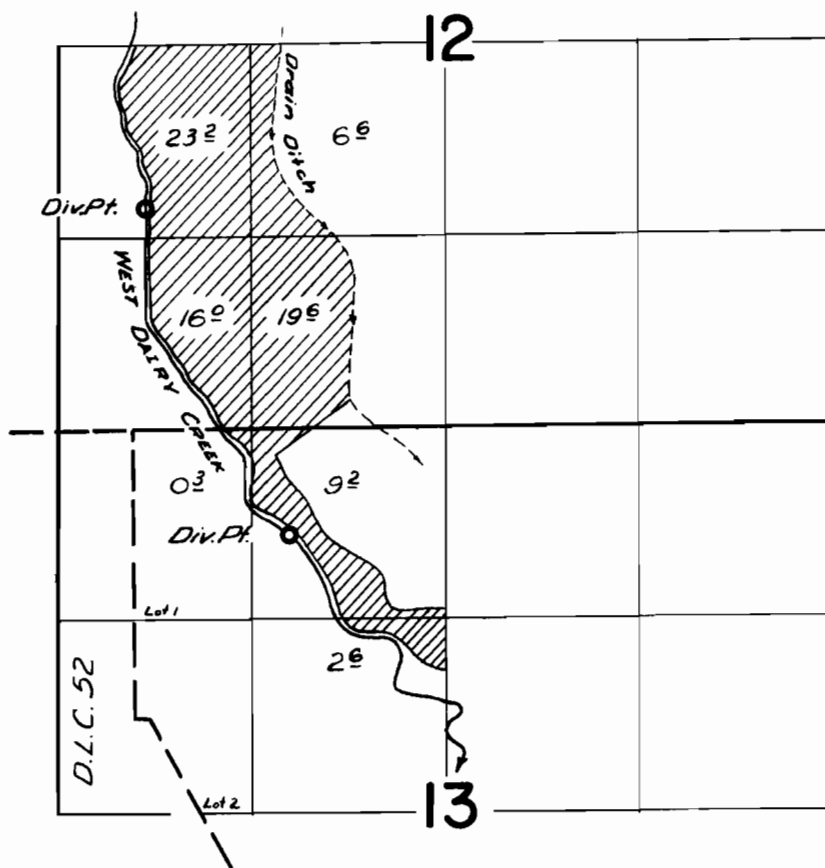

FINAL PROOF SURVEY UNDER

Application No. 26819 Permit No. 21061
IN NAME OF

KAUER BROS.

Surveyed 17 AUG. 1961. by Mr. Bish