


T.2S.R.2W.W.M.

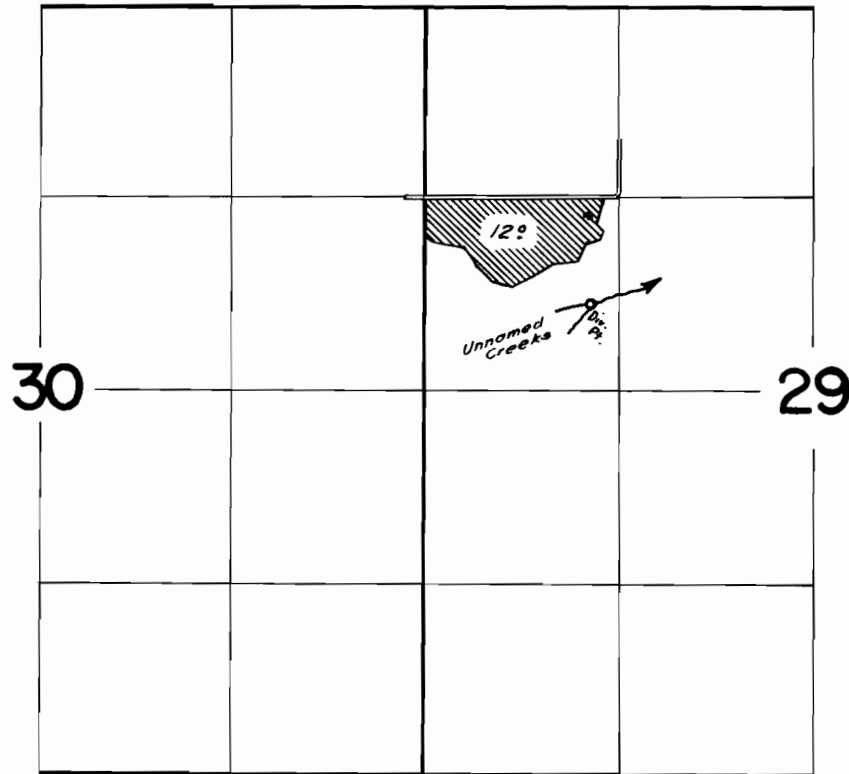

FINAL PROOF SURVEY
UNDER

Application No. **27217** Permit No. **21401**....
IN NAME OF

F. A. NICHOLS

Surveyed *August 15 1961* , by

R. H. Jackson