


T.1N&1S.R.2W.W.M.

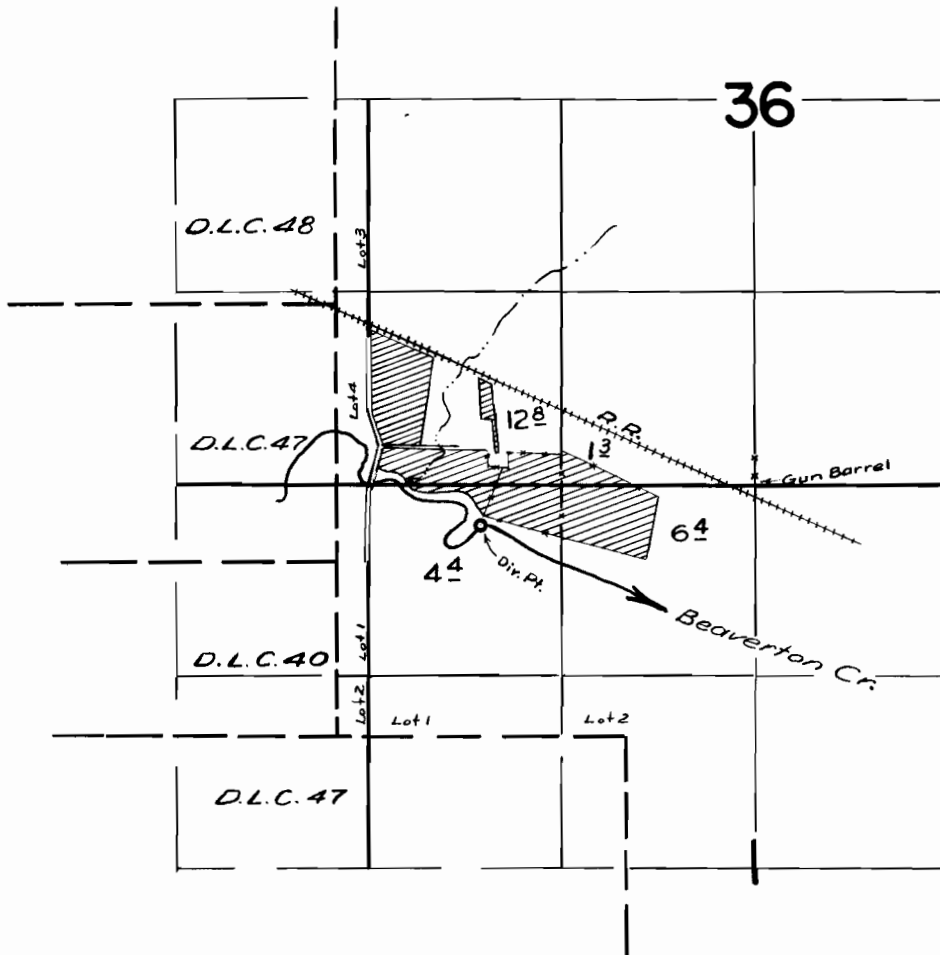

FINAL PROOF SURVEY
UNDER

Application No. 30418 Permit No. 23983
IN NAME OF

FRANK J. KOSMALSKI

Surveyed AUG. 18 1961, by Mr. Bish