


T.I.S.R.4 W.W.M.

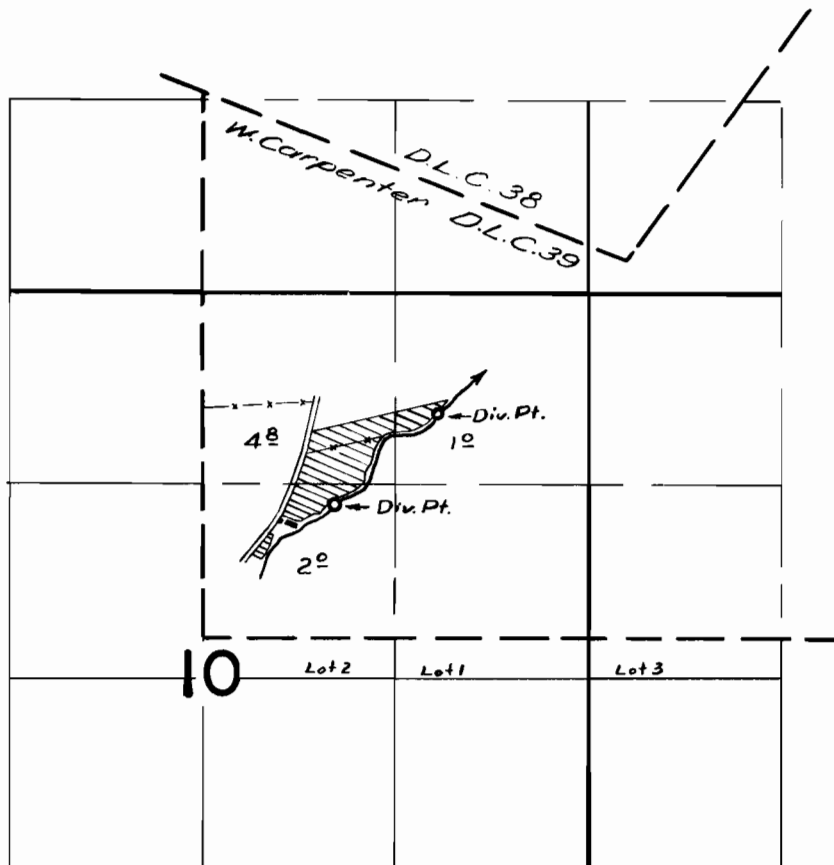

FINAL PROOF SURVEY UNDER

Application No. 30895 Permit No. 24879
IN NAME OF

HOWARD T. & HELEN E. WAHL

Surveyed 18 AUG. 1961, by m. A. Bish