


T.I.S.R. 3W.W.M.

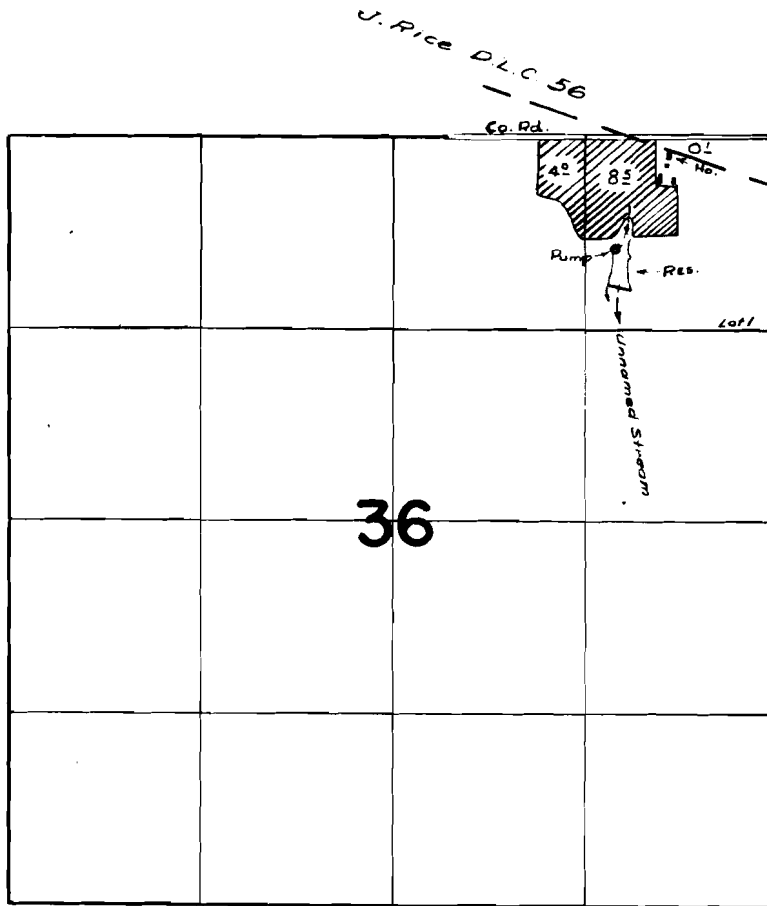

FINAL PROOF SURVEY UNDER

Application No. ³¹⁷⁵⁵ ~~R-31754~~ Permit No. ²⁵⁰⁴⁴ ~~R-2055~~
IN NAME OF

FRANK J. LORENCE

Surveyed 17 AUG. 1961, by *m. Bish*