


T. 1 S. R. 3 W. W. M.

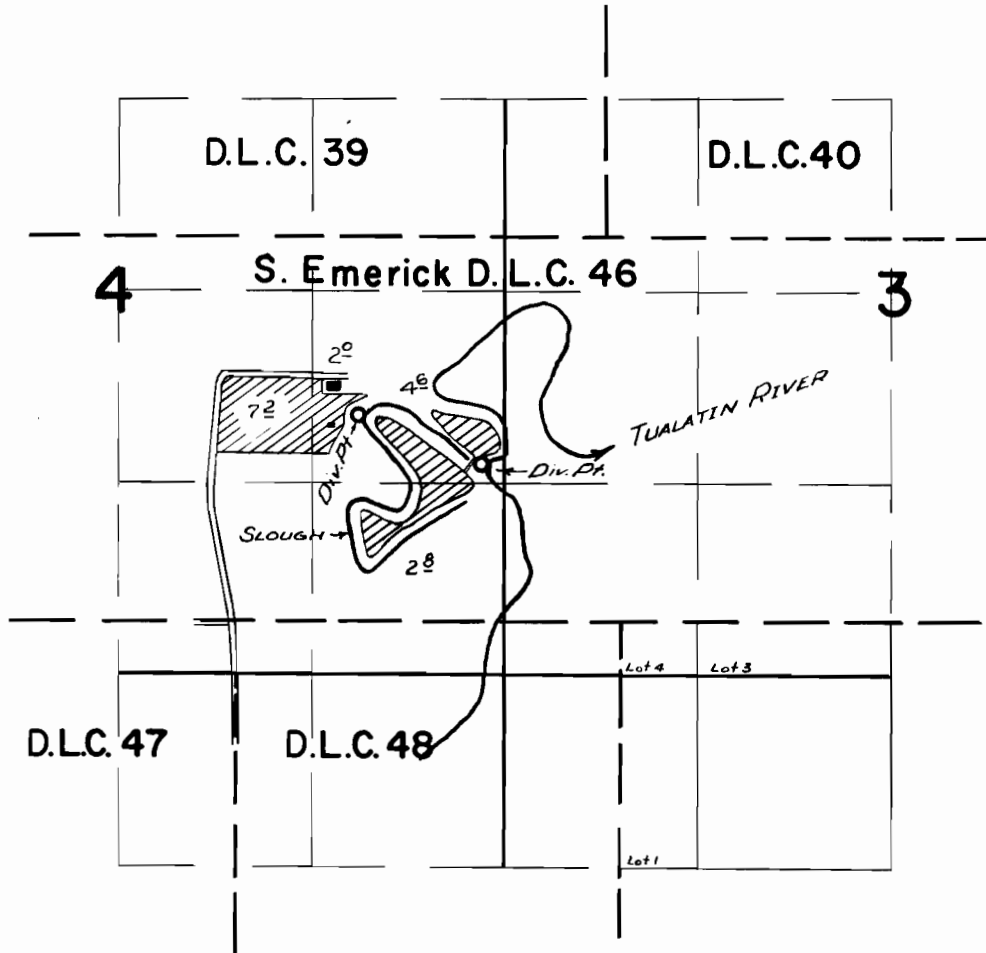

FINAL PROOF SURVEY
UNDER

Application No. 31701 ... Permit No. 25142...
IN NAME OF

CHARLES J. KINSEY

Surveyed 16 AUG. 1961, by m. Bish