


T.9S.R.23E.W.M.

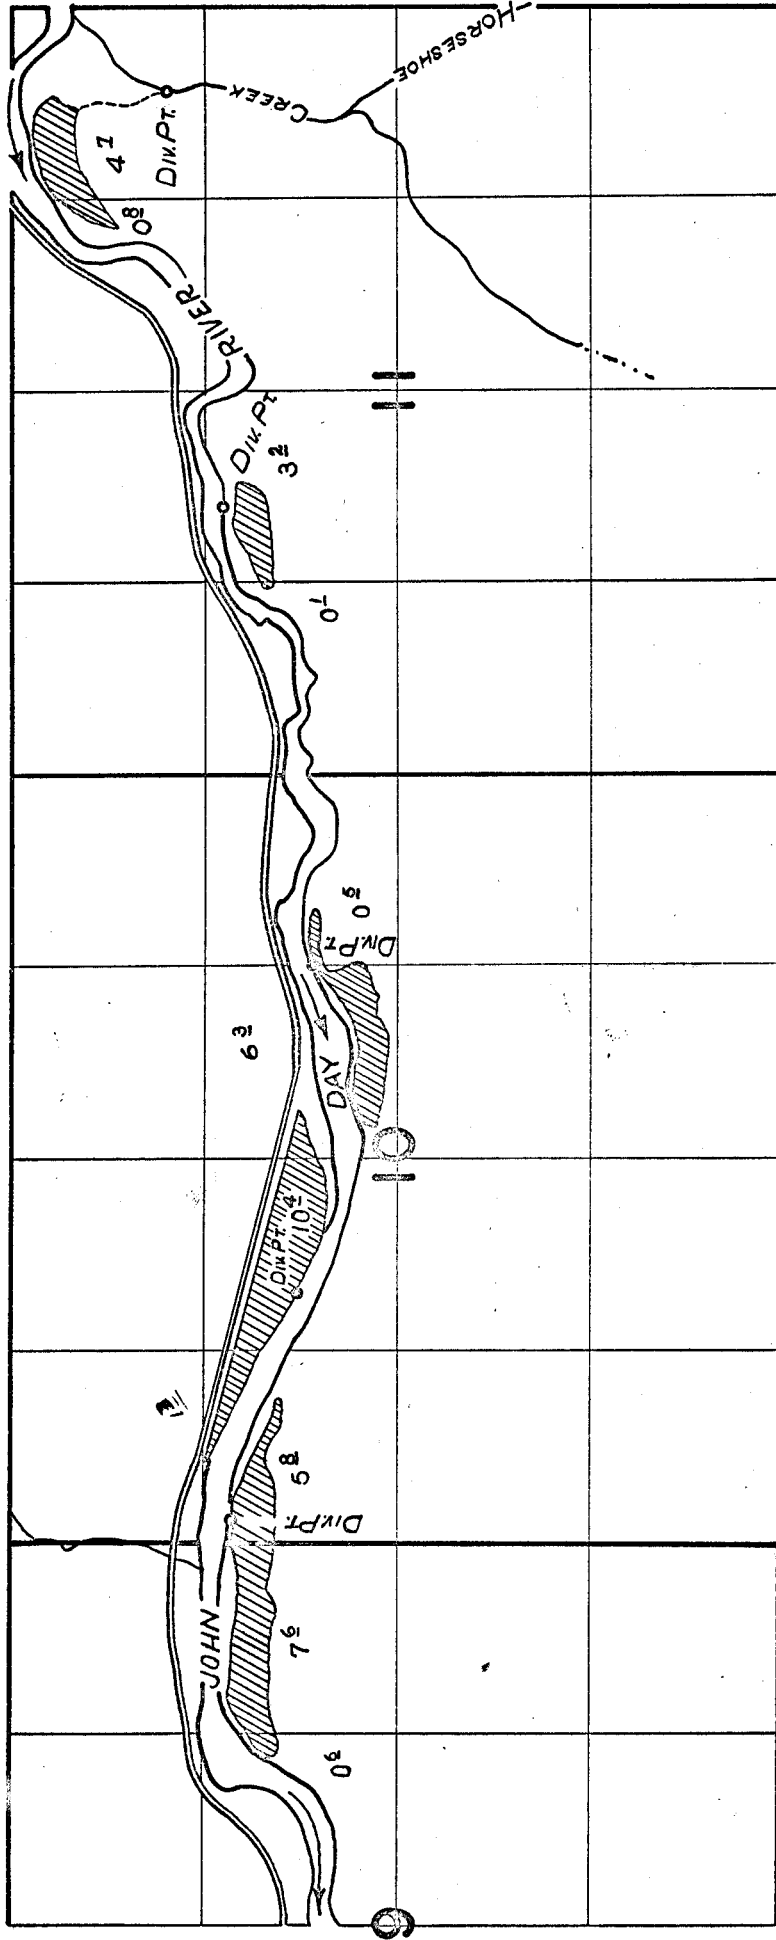

MINAL PROOF SURVEY

UNDER

Application No. 29532, Permit No. 23274

IN NAME OF

JOE H. & STANLEY BOLIN

Surveyed Oct. 10, 1961, by C. BARTELS

P- 23274
30232
DOV. 111 100