


T.8S.R.24E.W.M.

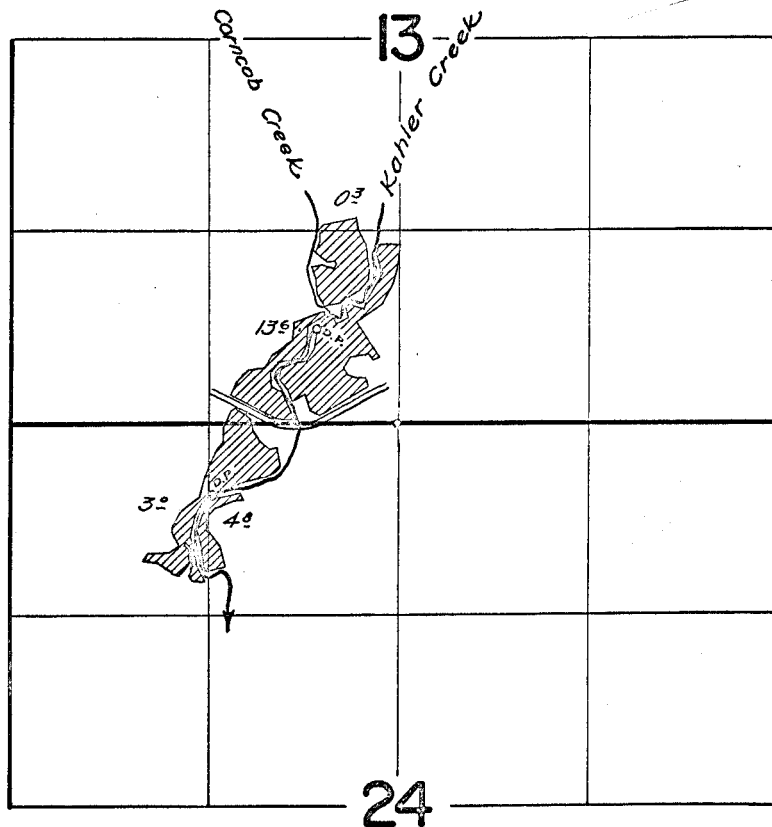

FINAL PROOF SURVEY
UNDER

Application No. 32212..... Permit No. 25474.....
IN NAME OF

.....ARTHUR F. STEPHENS.....

Surveyed October 12 1961., by C.O. Bartels..