


T. 11 S. R. 5 W. W. M

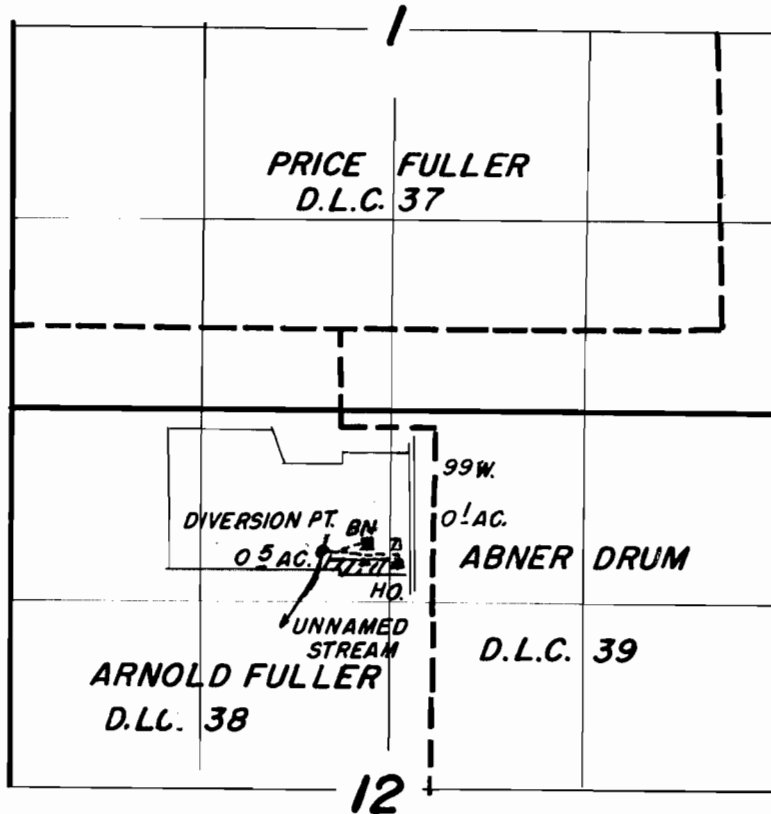

FINAL PROOF SURVEY
UNDER

Application No. 32684 Permit No. 25804
IN NAME OF

JOHN R. BUREN

Surveyed JULY 24 1962, by Floyd L. Siegmund