


T. 11 S. R. 5 W. W.M.

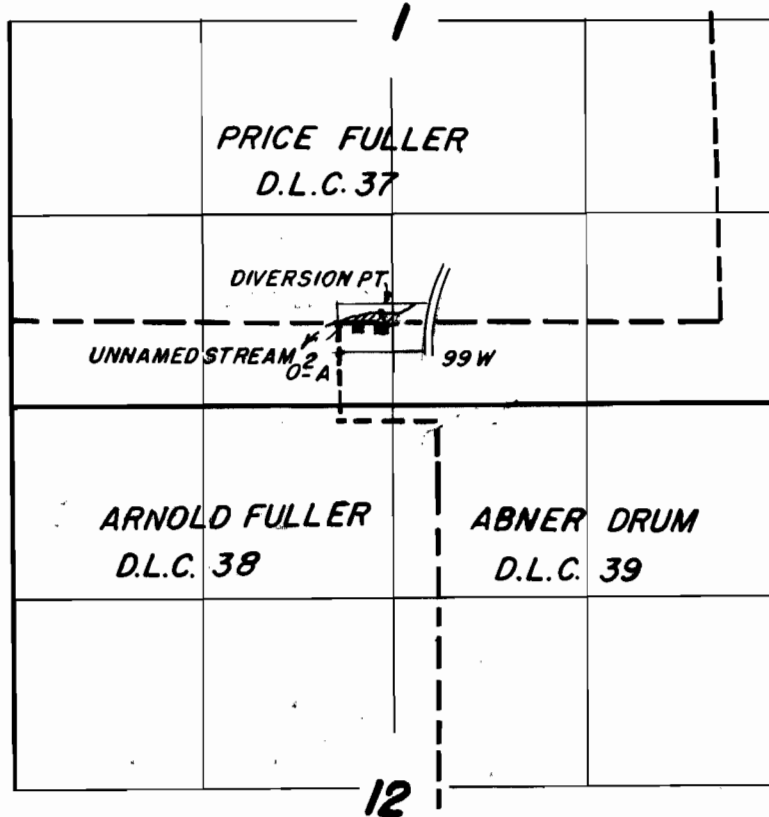

**FINAL PROOF SURVEY
UNDER**

Application No. 33205 Permit No. 26253
IN NAME OF

ARTHUR W. ANDERSON

Surveyed JULY 24 1962, by Floyd L. Sigmond