


T.34S.R.11W.W.M.

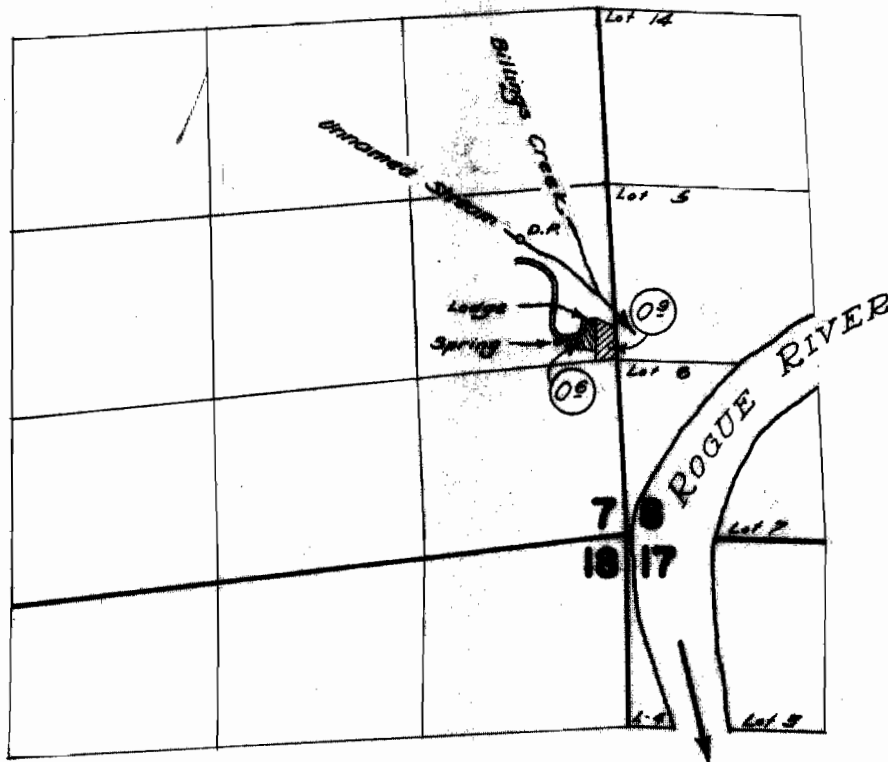

FINAL PROOF SURVEY
UNDER

Application No. **21095**..... Permit No. **16682**.....
IN NAME OF

E.J. Schneider, Mrs. F.E. Schneider & B.R. Rutledge

Surveyed *August 28 1961*., by *C.O. Bartels*..