


RECEIVED  
JAN 8 1960

RECEIVED  
DEC 16 1959

E


STATE ENGINEER  
GREEN CHIEF

STATE ENGINEER  
GREEN CHIEF

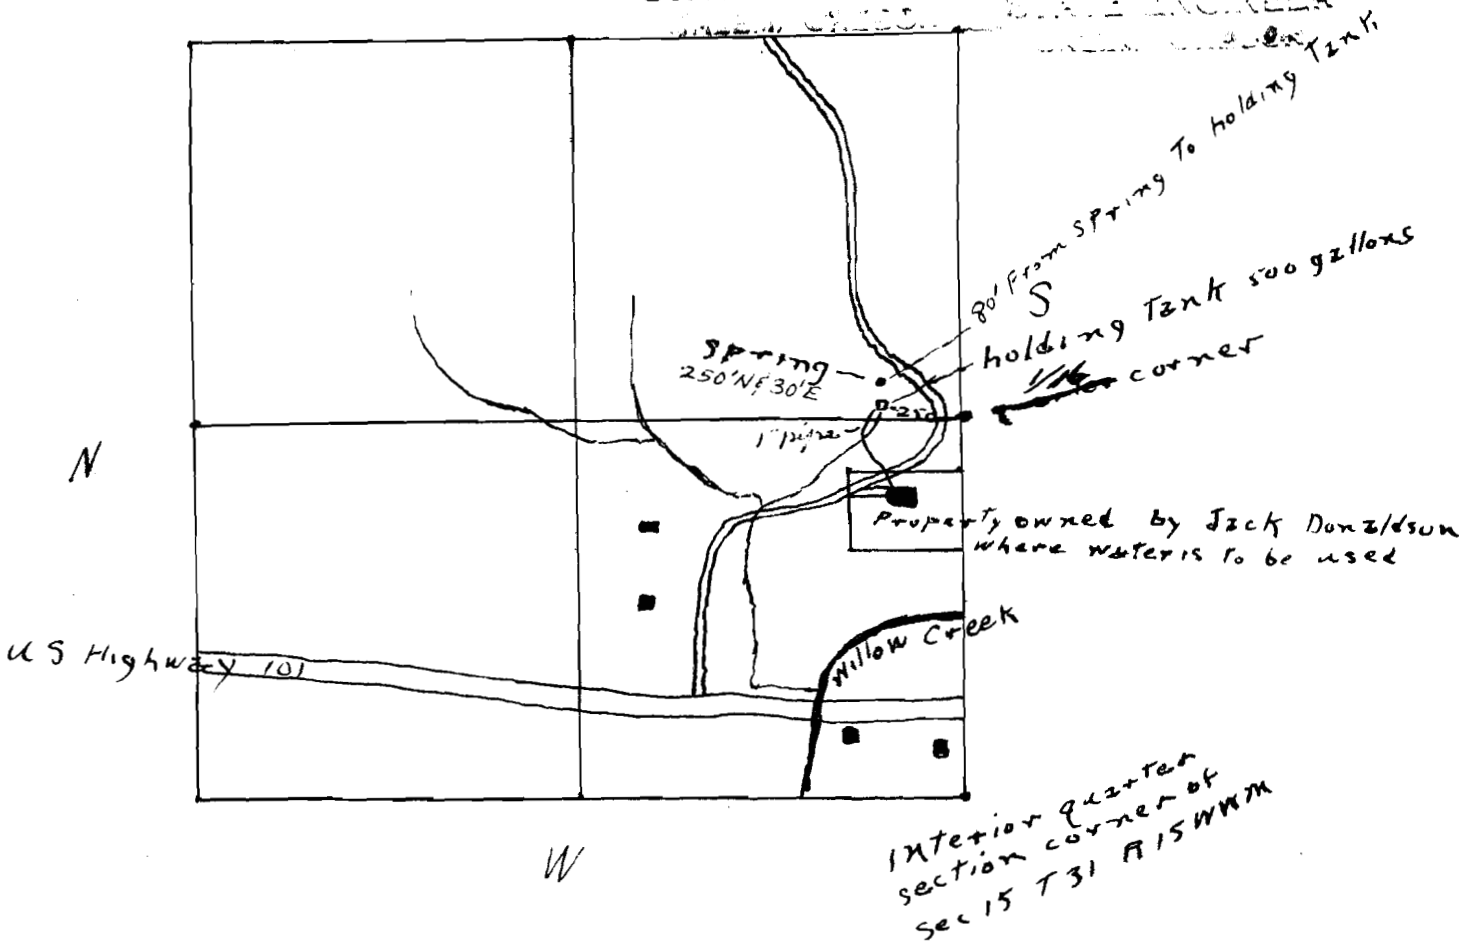

U S Highway 101

2" to 1320'

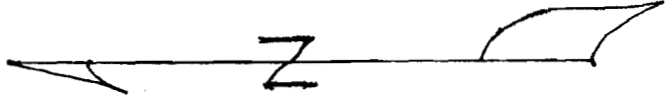

Application No. 33507  
Permit No. 26481