


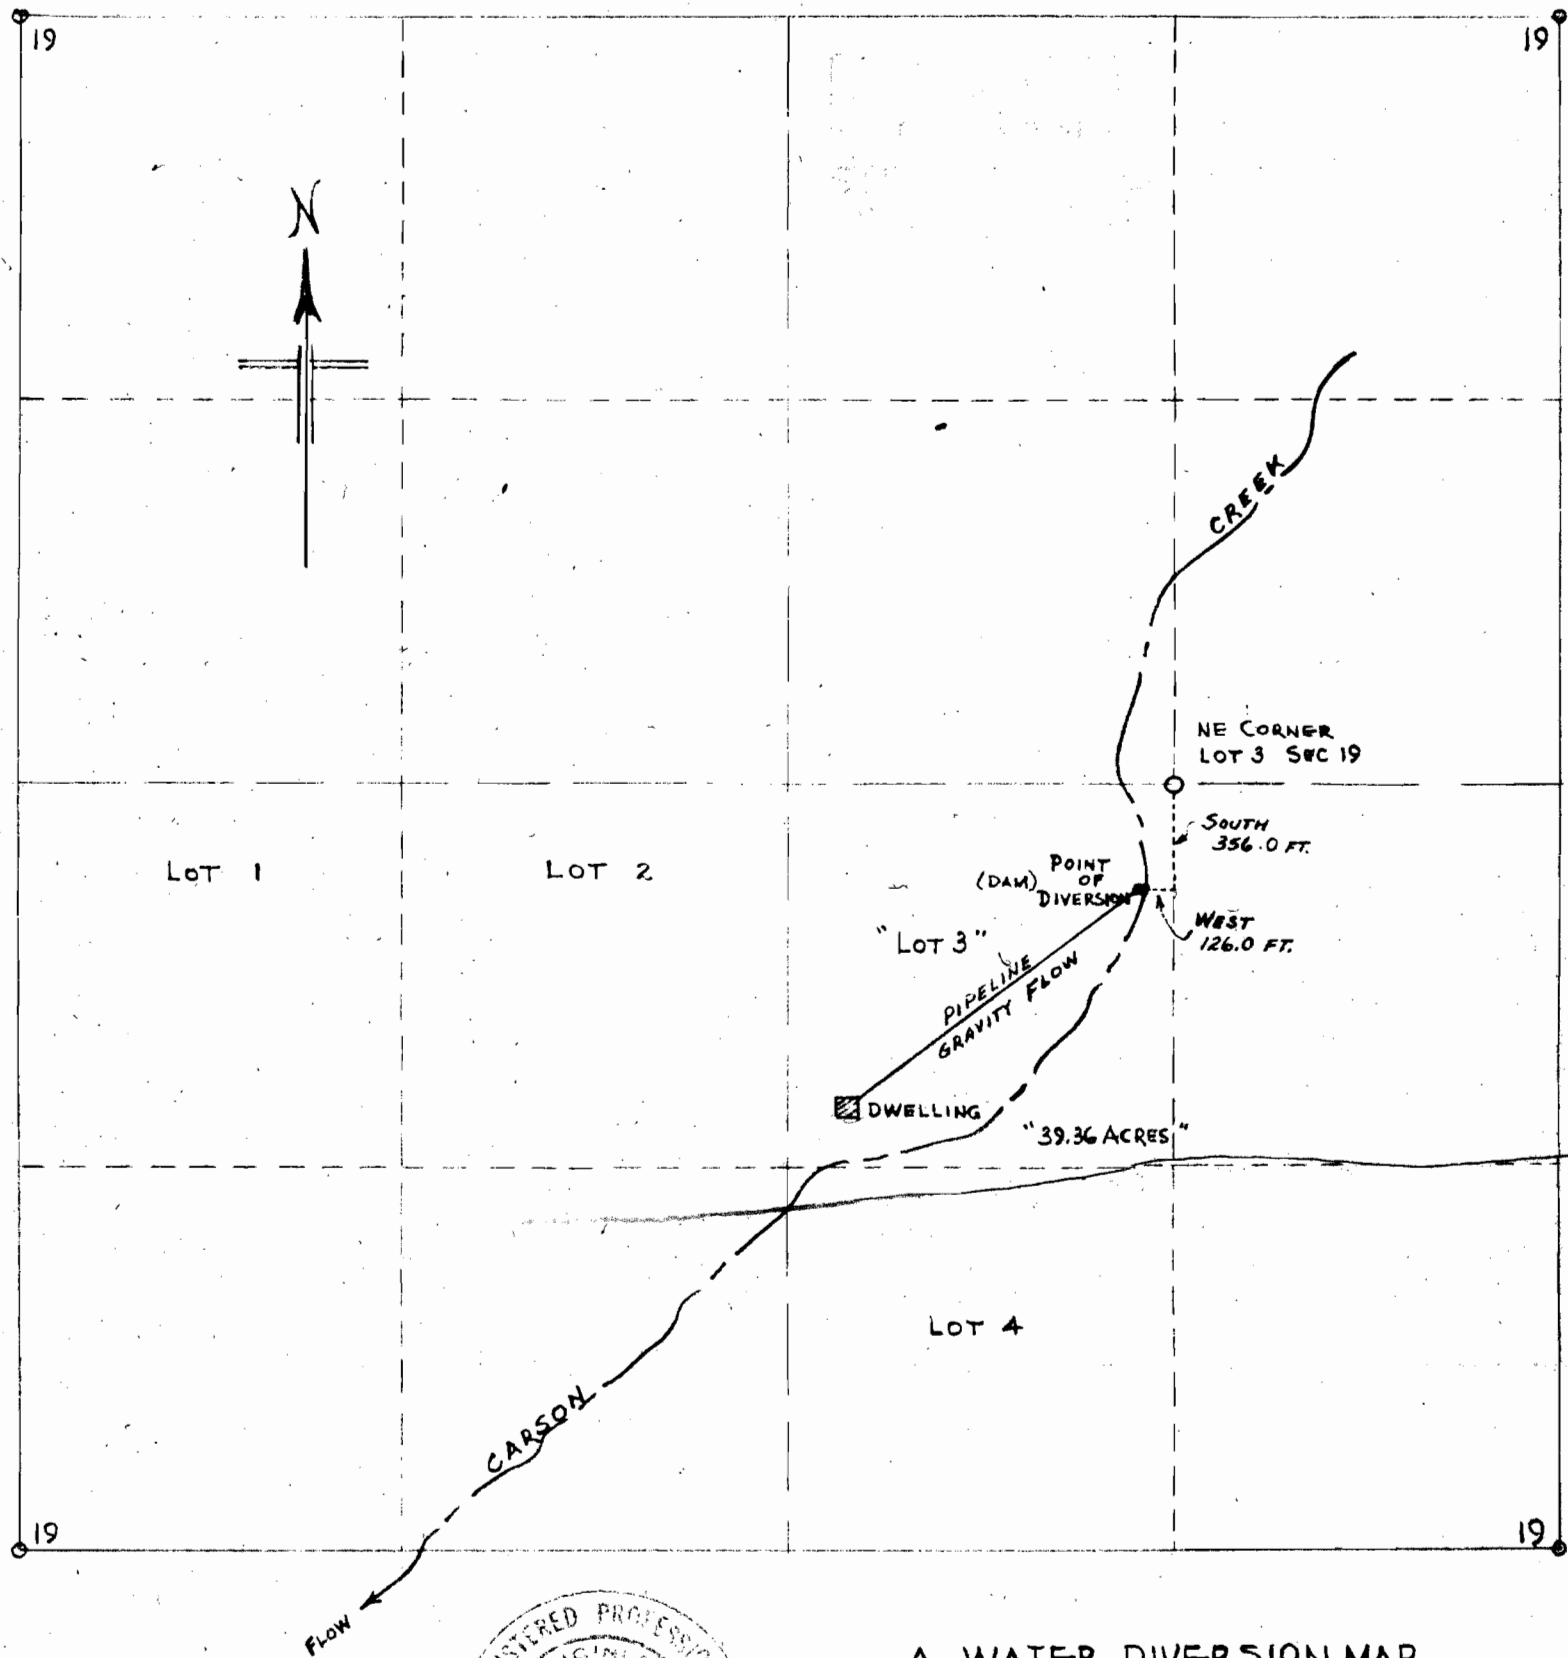

SEC. 19 T29S R4W W.M.
DOUGLAS COUNTY, OREGON



A WATER DIVERSION MAP
ARTHUR V. HALL
MYRTLE CREEK, OREGON

SCALE: 8 IN. = 1 MI.

NOVEMBER 1958

MARTIN ENGINEERING SERVICE - MYRTLE CREEK, ORE.

Application No. 32798

Permit No. 25875