


T.22S. R.7W.W.M.

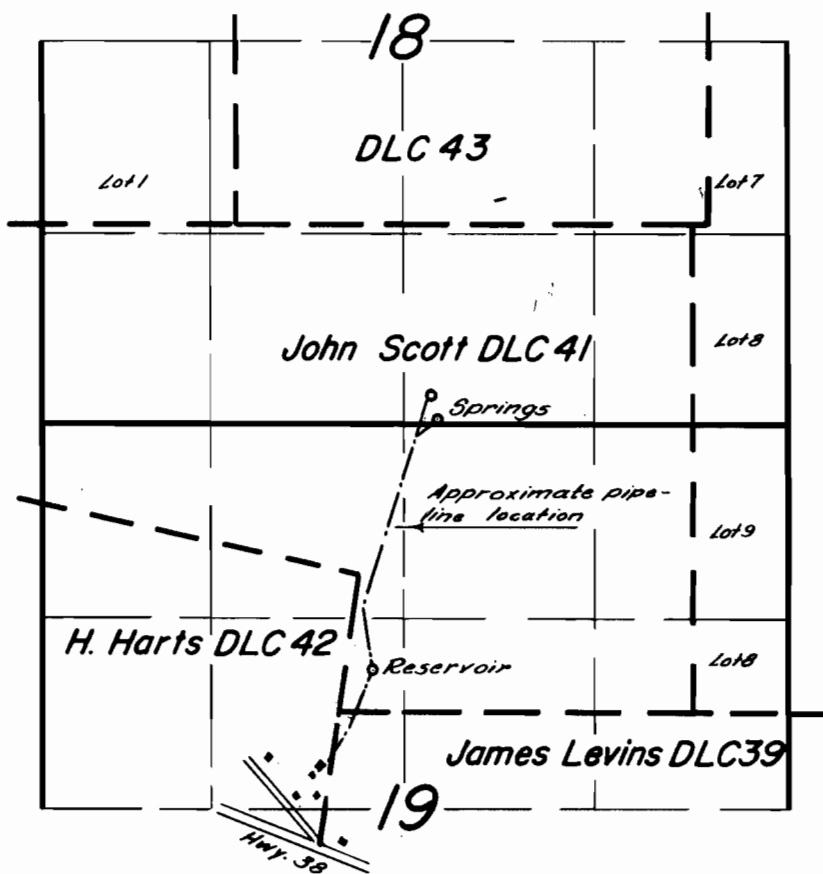

Note: Spring locations taken from application map.

**FINAL PROOF SURVEY**  
UNDER

Application No. 34652 Permit No. 27466  
IN NAME OF

Frank W. & Nellie M. Binder

Surveyed Aug. 30, 1962, by G.O. Bartels

