


T.40S.R.12 E.W.M.

East River Wells

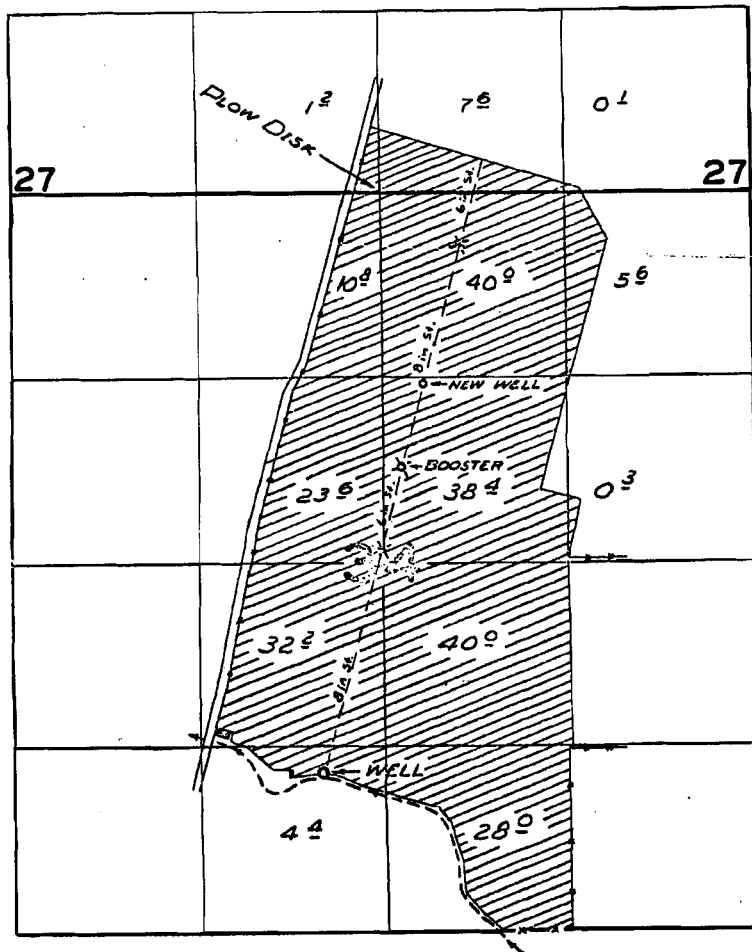

FINAL PROCT SURVEY

UNDER

Application No. U-393 Permit No. U-361

IN NAME OF

C. G. GROSS & MADELINE J. GROSS

Surveyed 20 Oct. 19 59, by M. Bish