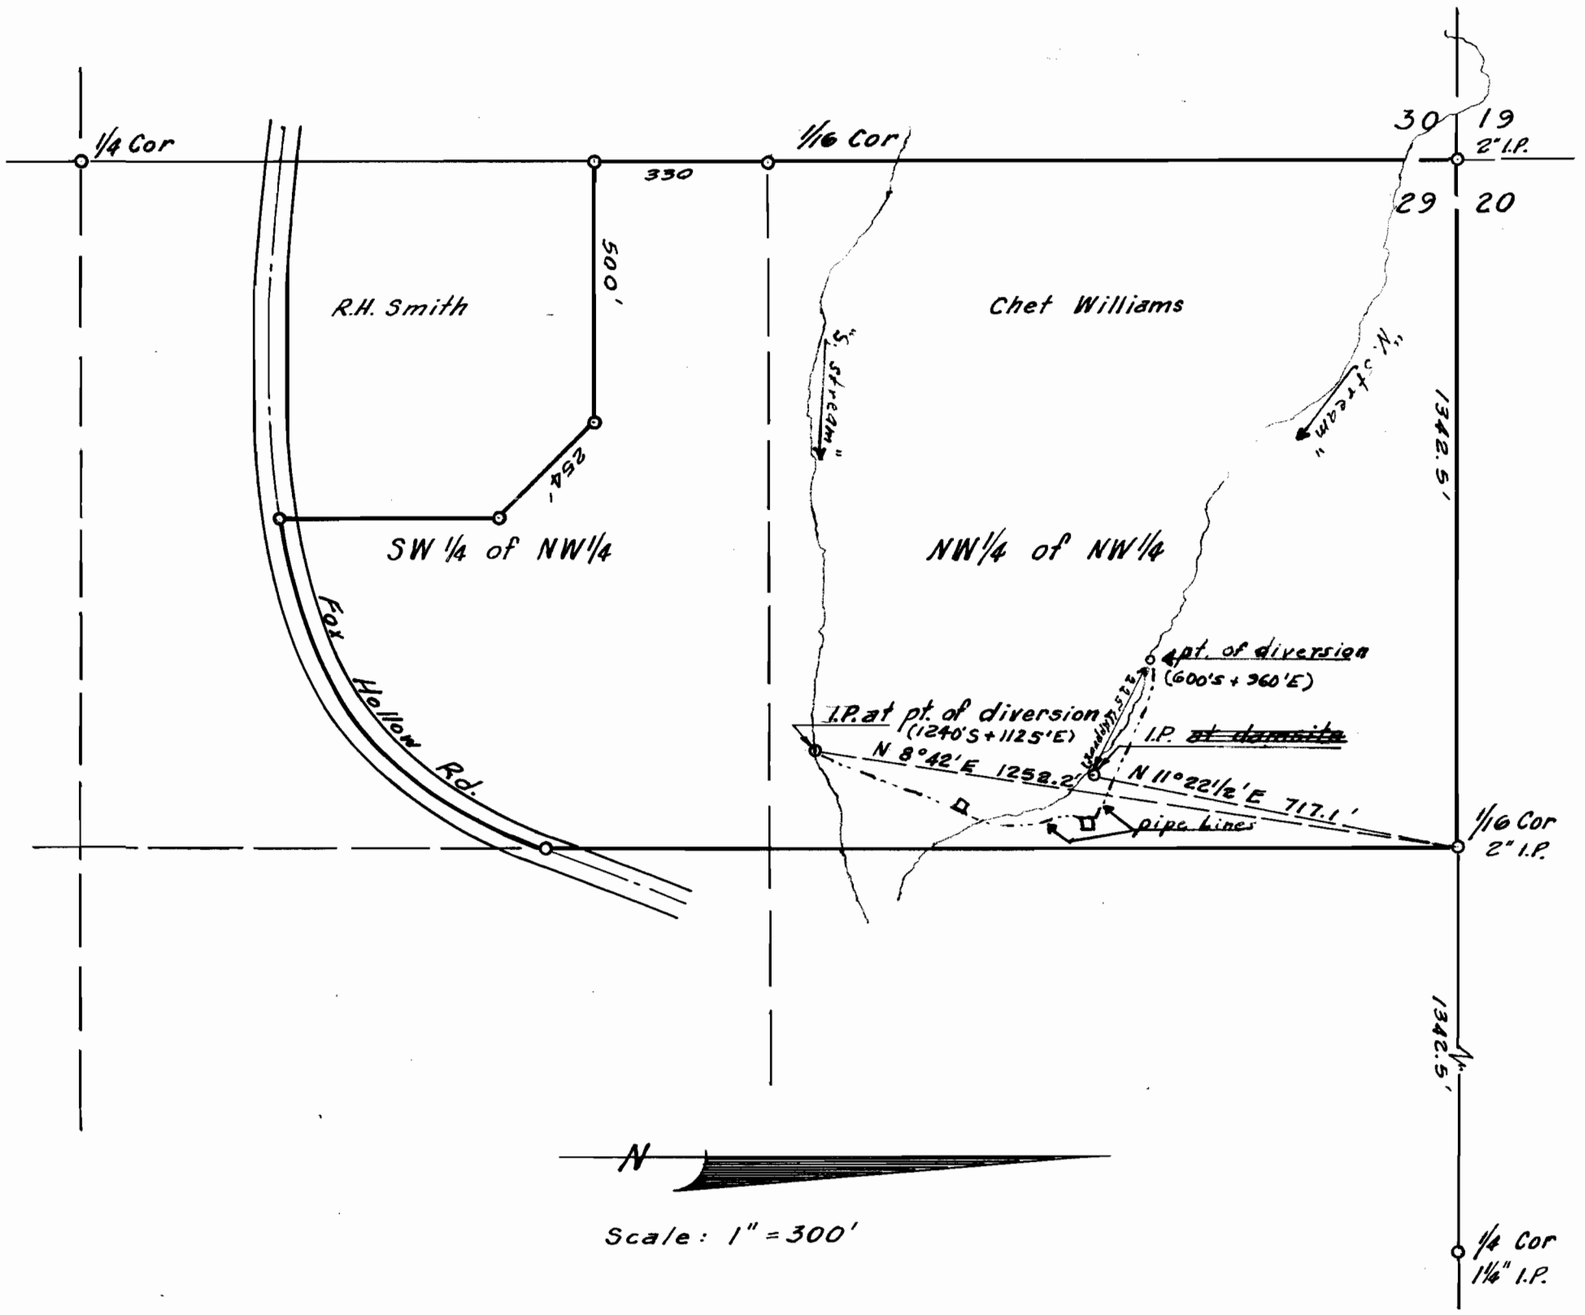



PROPERTY DESCRIPTION:

The N W quarter of the N W quarter and that part of the S W quarter of the N W quarter of Section 29 T 18 S, R.3 W of the W.M., Lane County, Oregon, lying North of the County Road known as Fox Hollow Road, except the following:

Beginning at a stake and mound of rocks on the West line of Section 29, T,18 S., R.3 W. of the W. M., 330 feet South of the North West corner of the Southwest quarter of the Northwest quarter of said Section 29, run thence East 500 feet, to a 10 inch spike driven in the top of a 38 inch Fir stump, thence South 45° East 254 feet to a stake in a mound of rocks on the North-South line of the Southwest quarter of the Northwest quarter, thence South on the center line of the Southwest quarter of the Northwest quarter to the North line of the County Road known as Fox Hollow Road, thence in a Westerly direction on the North line of said road to the West line of Section 29, thence North along said West line to the Point of Beginning, in Lane, County Oregon.

Application No. 31424
Permit No. 25138

Eugene D. Schmidt

Western Engineering Consultants
110 E. 12th Avenue
Eugene, Oregon

Water Right Map for
Chet Williams
Eugene, Oregon
Section 29, Township 18 South
Range 3 West, W. M.
Lane County, Oregon