


MAP
 FOR
 WATER RIGHT
 FOR
C.W. CLANCY
 IN
 SEC. 19 T18S-R3W-W.M.

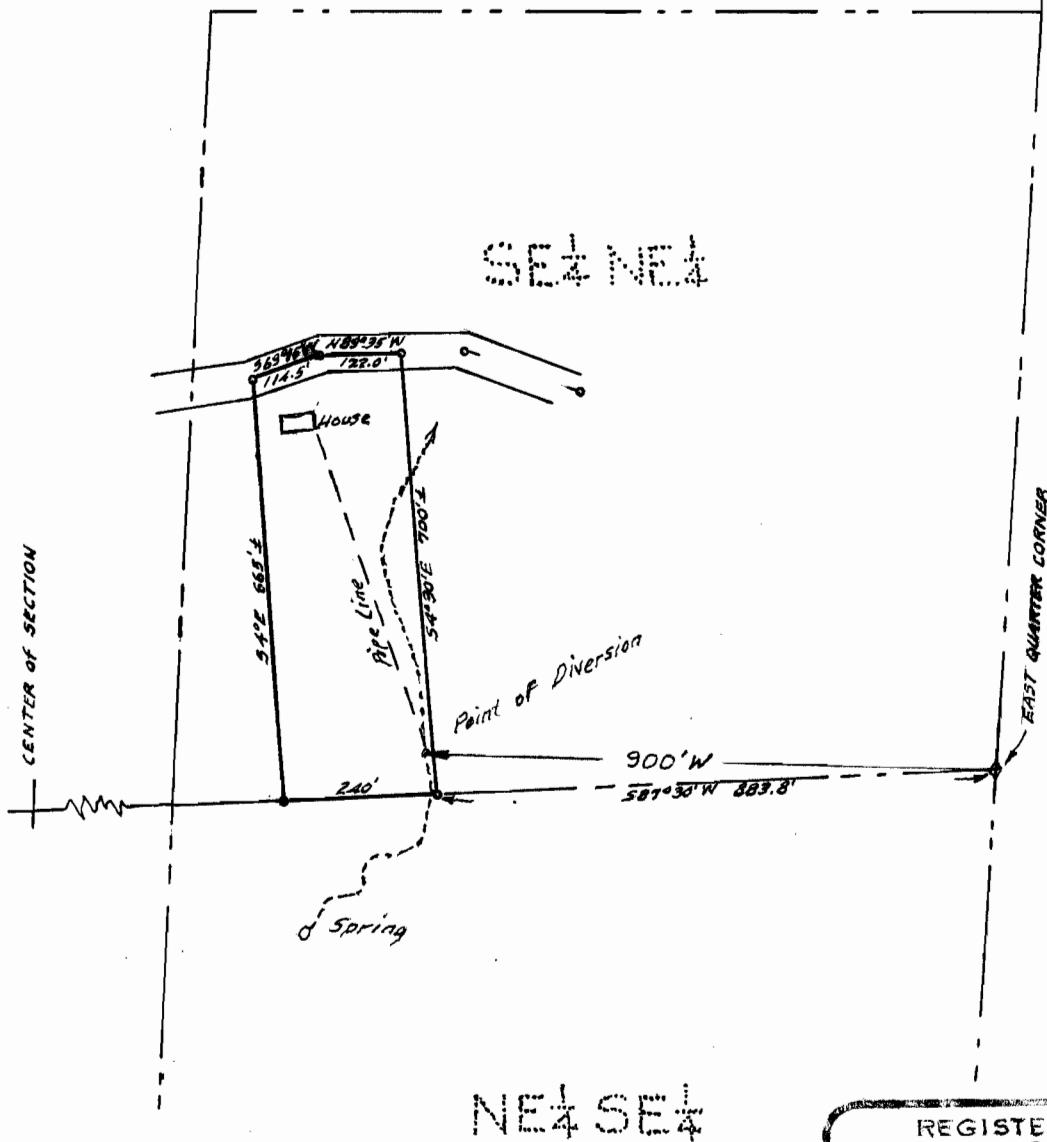

SCALE 1" = 300' APRIL 1959.

18 | 17
 19 | 20



REGISTERED
OREGON
 LAND SURVEYOR

Albert Landerberg
 NOVEMBER 7, 1947
ALBERT LANDERBERG
 219

Application No. **33262**
 Permit No. **26298**