




RECEIVED
AUG 16 1960
STATE ENGINEER
SALEM, OREGON

RECEIVED
AUG 30 1960
STATE ENGINEER
SALEM, OREGON

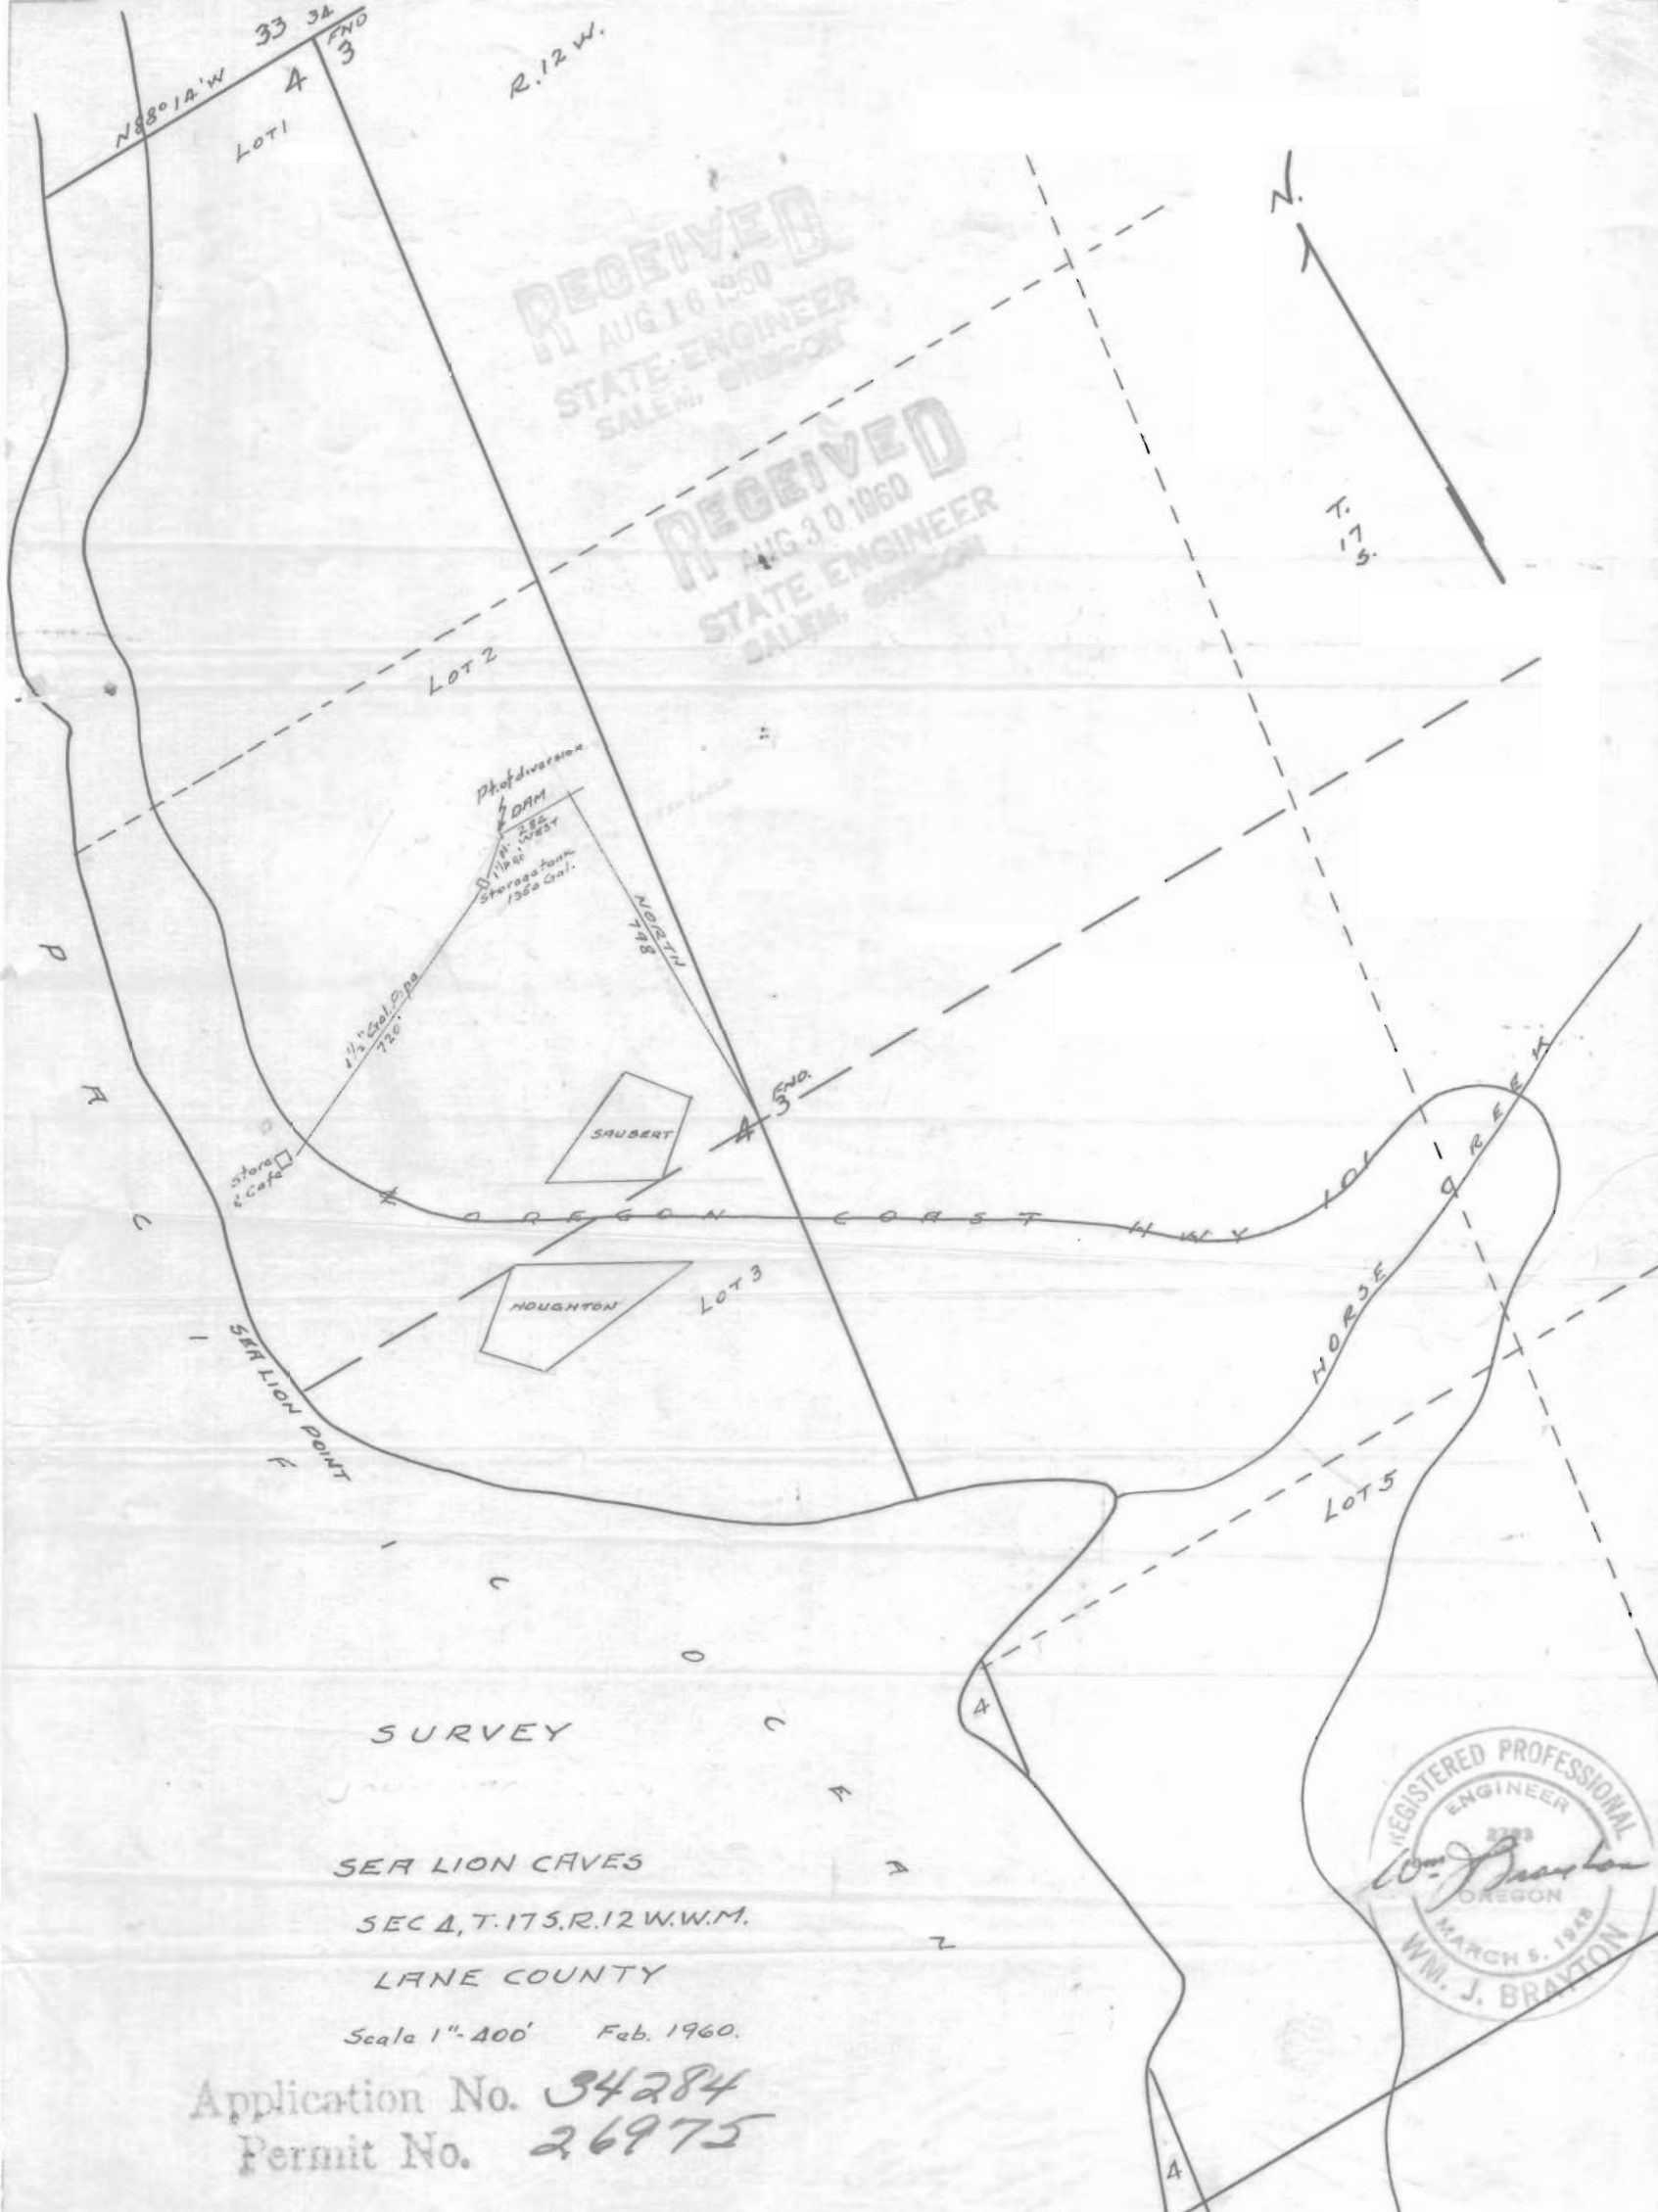

SURVEY

SEA LION CAVES

SEC 4, T. 17 S., R. 12 W., W. M.

LANE COUNTY

Scale 1" = 400' Feb. 1960.

Application No. 34284
Permit No. 26975