


Application No. 34412  
Easement No. 27030

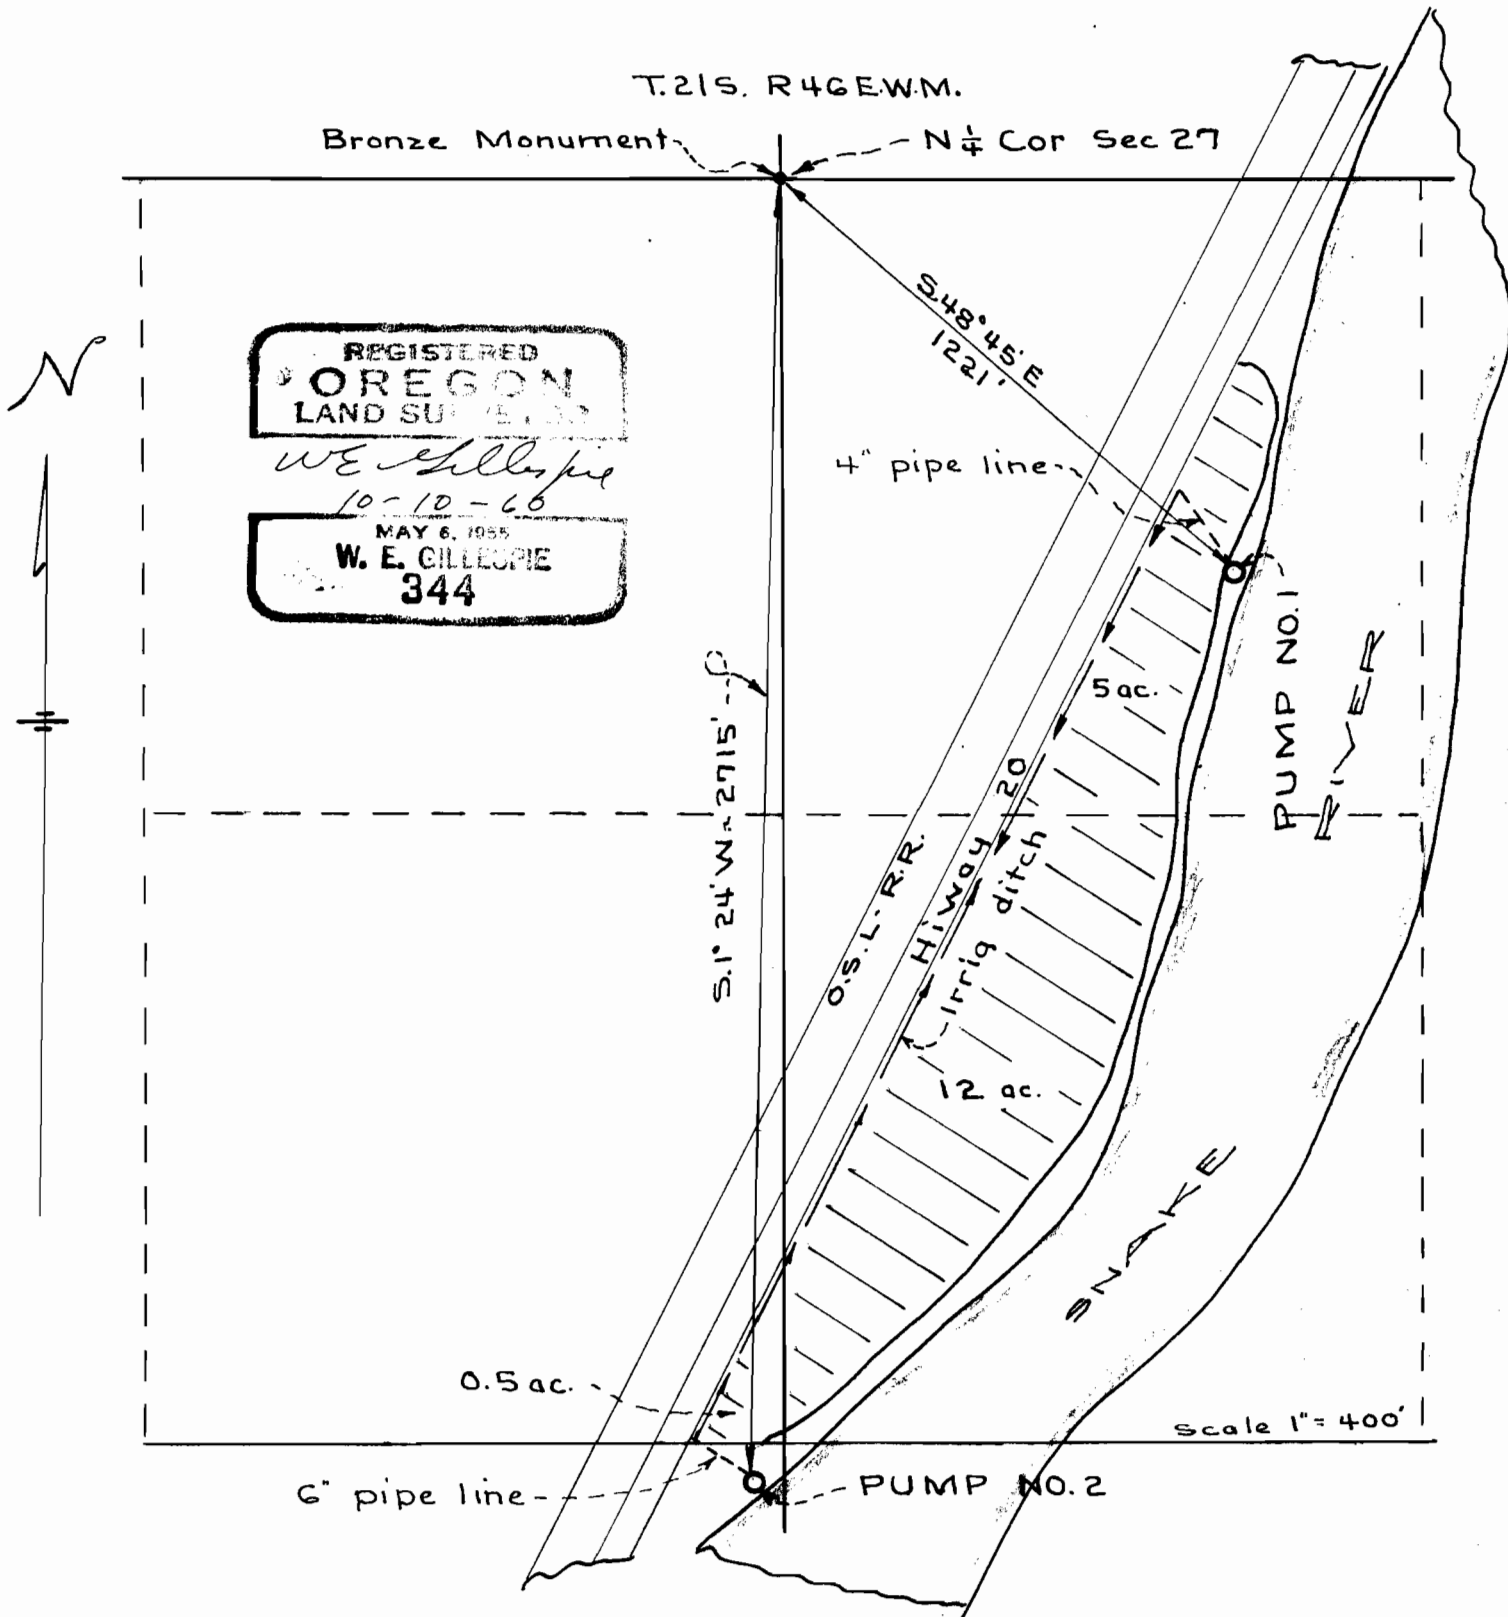

APPLICATION FOR PERMIT  
M.H. Pitcher, Adrian, Ore.