


T. 9S. R. 1W. W.M.

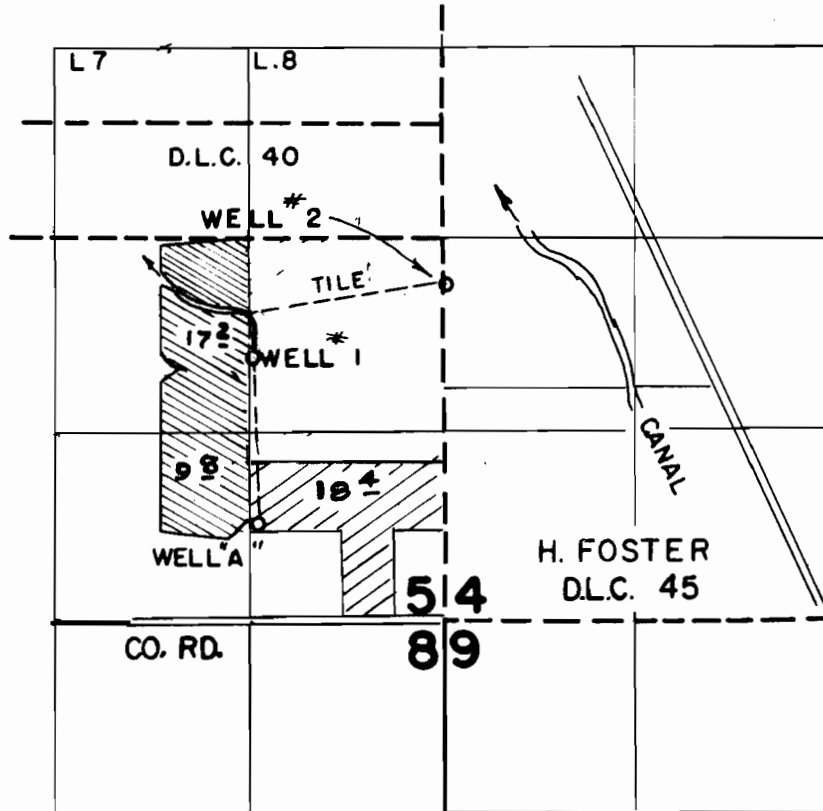

**FINAL PROOF SURVEY**  
UNDER

Application No. G-1749 Permit No. G-1600  
IN NAME OF

**Louis Hendricks**

Surveyed 20 JULY 1962, by Hoyt L. Sigmund