


T. 10 S. R. 2 W. W. M.

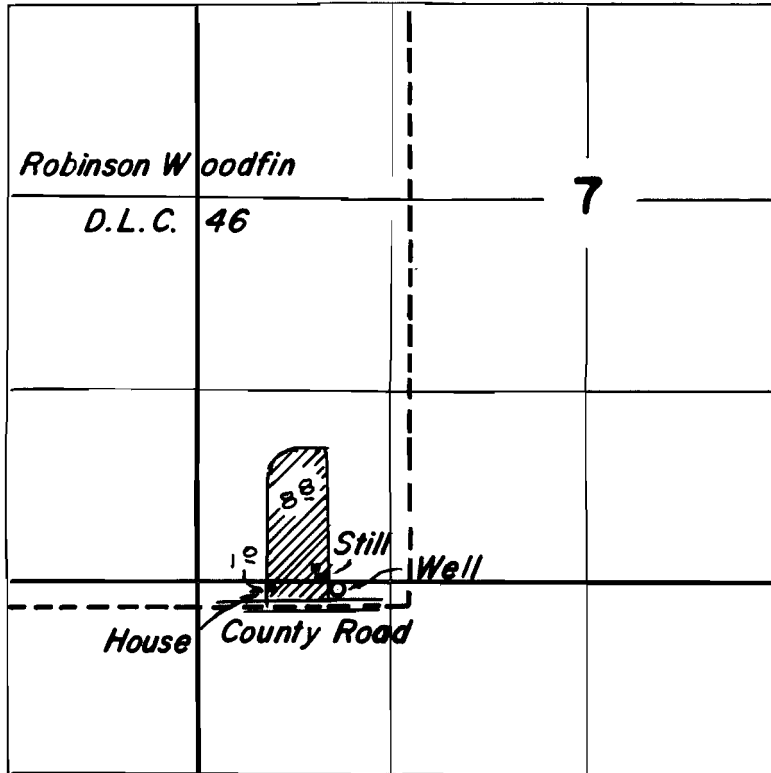

FINAL PROOF SURVEY
UNDER

Application No. G 1902 Permit No. G 1757
IN NAME OF

O.D. STEPHENSON

Surveyed Aug. 31, 1962, by Floyd L. Sigmund