


T. 10 S. R. 3 W. W. M.

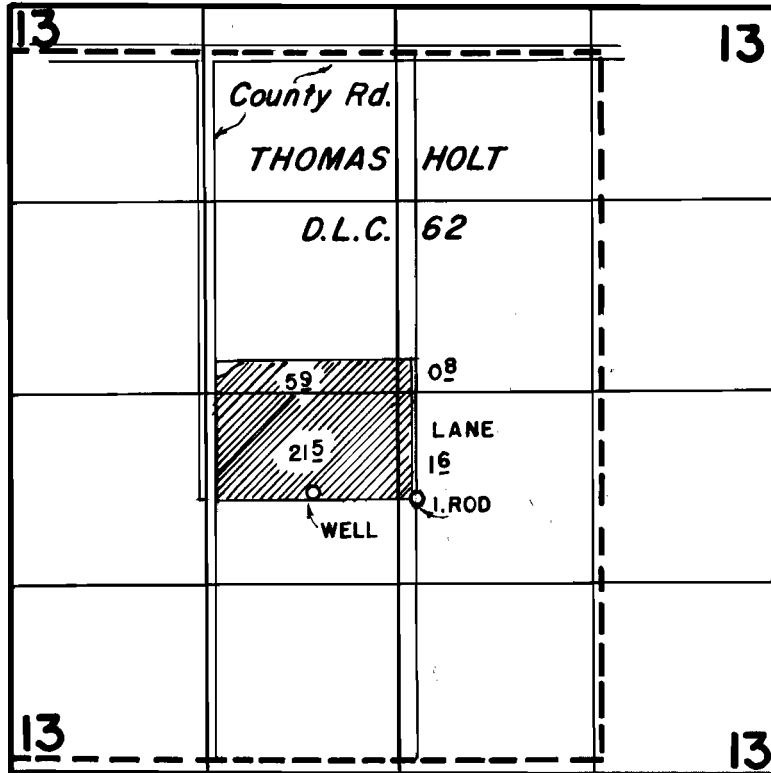

FINAL PROOF SURVEY
UNDER

Application No. G-1988 Permit No. G-1829
IN NAME OF

EZRA C. HART

Surveyed Aug. 27 1962, by Floyd L. Siegmund