


T. 9 S. R. 1 W. W. M.

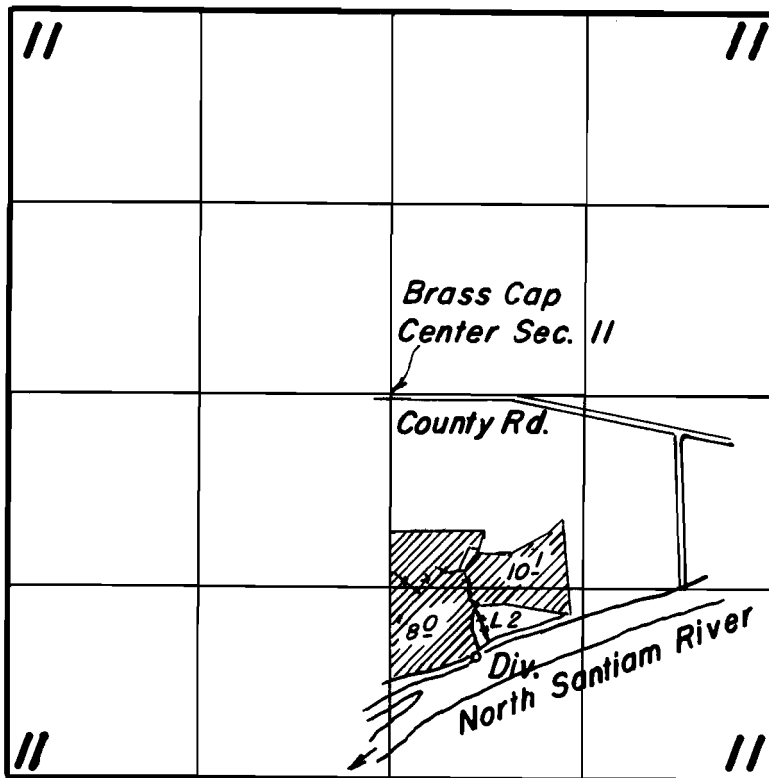

FINAL PROOF SURVEY
UNDER

Application No. 32910 Permit No. 26012
IN NAME OF

ORVILLE J. POOLE

Surveyed AUG. 14 1962, by Floyd L. Sigmond