

Map No. 34359 & R-34358
 Permit No. 27054 & R-2556


Map accompanying the application, by Stuckert-Minden Lumber Co., for Permit to appropriate Public Water for ponding and sorting of logs and fire protection at their sawmill located in the SW $\frac{1}{4}$ of SE $\frac{1}{4}$ of Sec. 16 T. 10 S. R. 6 E. W. M., Marion County, Oregon.

This is to certify that this map was made by me from notes taken during a field survey by me on Sept. 8, 1960 and by the use of data obtained from a blueprint copy of the Marion County Assessor's records, and that it reasonably represents the location of physical features pertinent to this application.

Signed

C. T. Darley

C. T. Darley

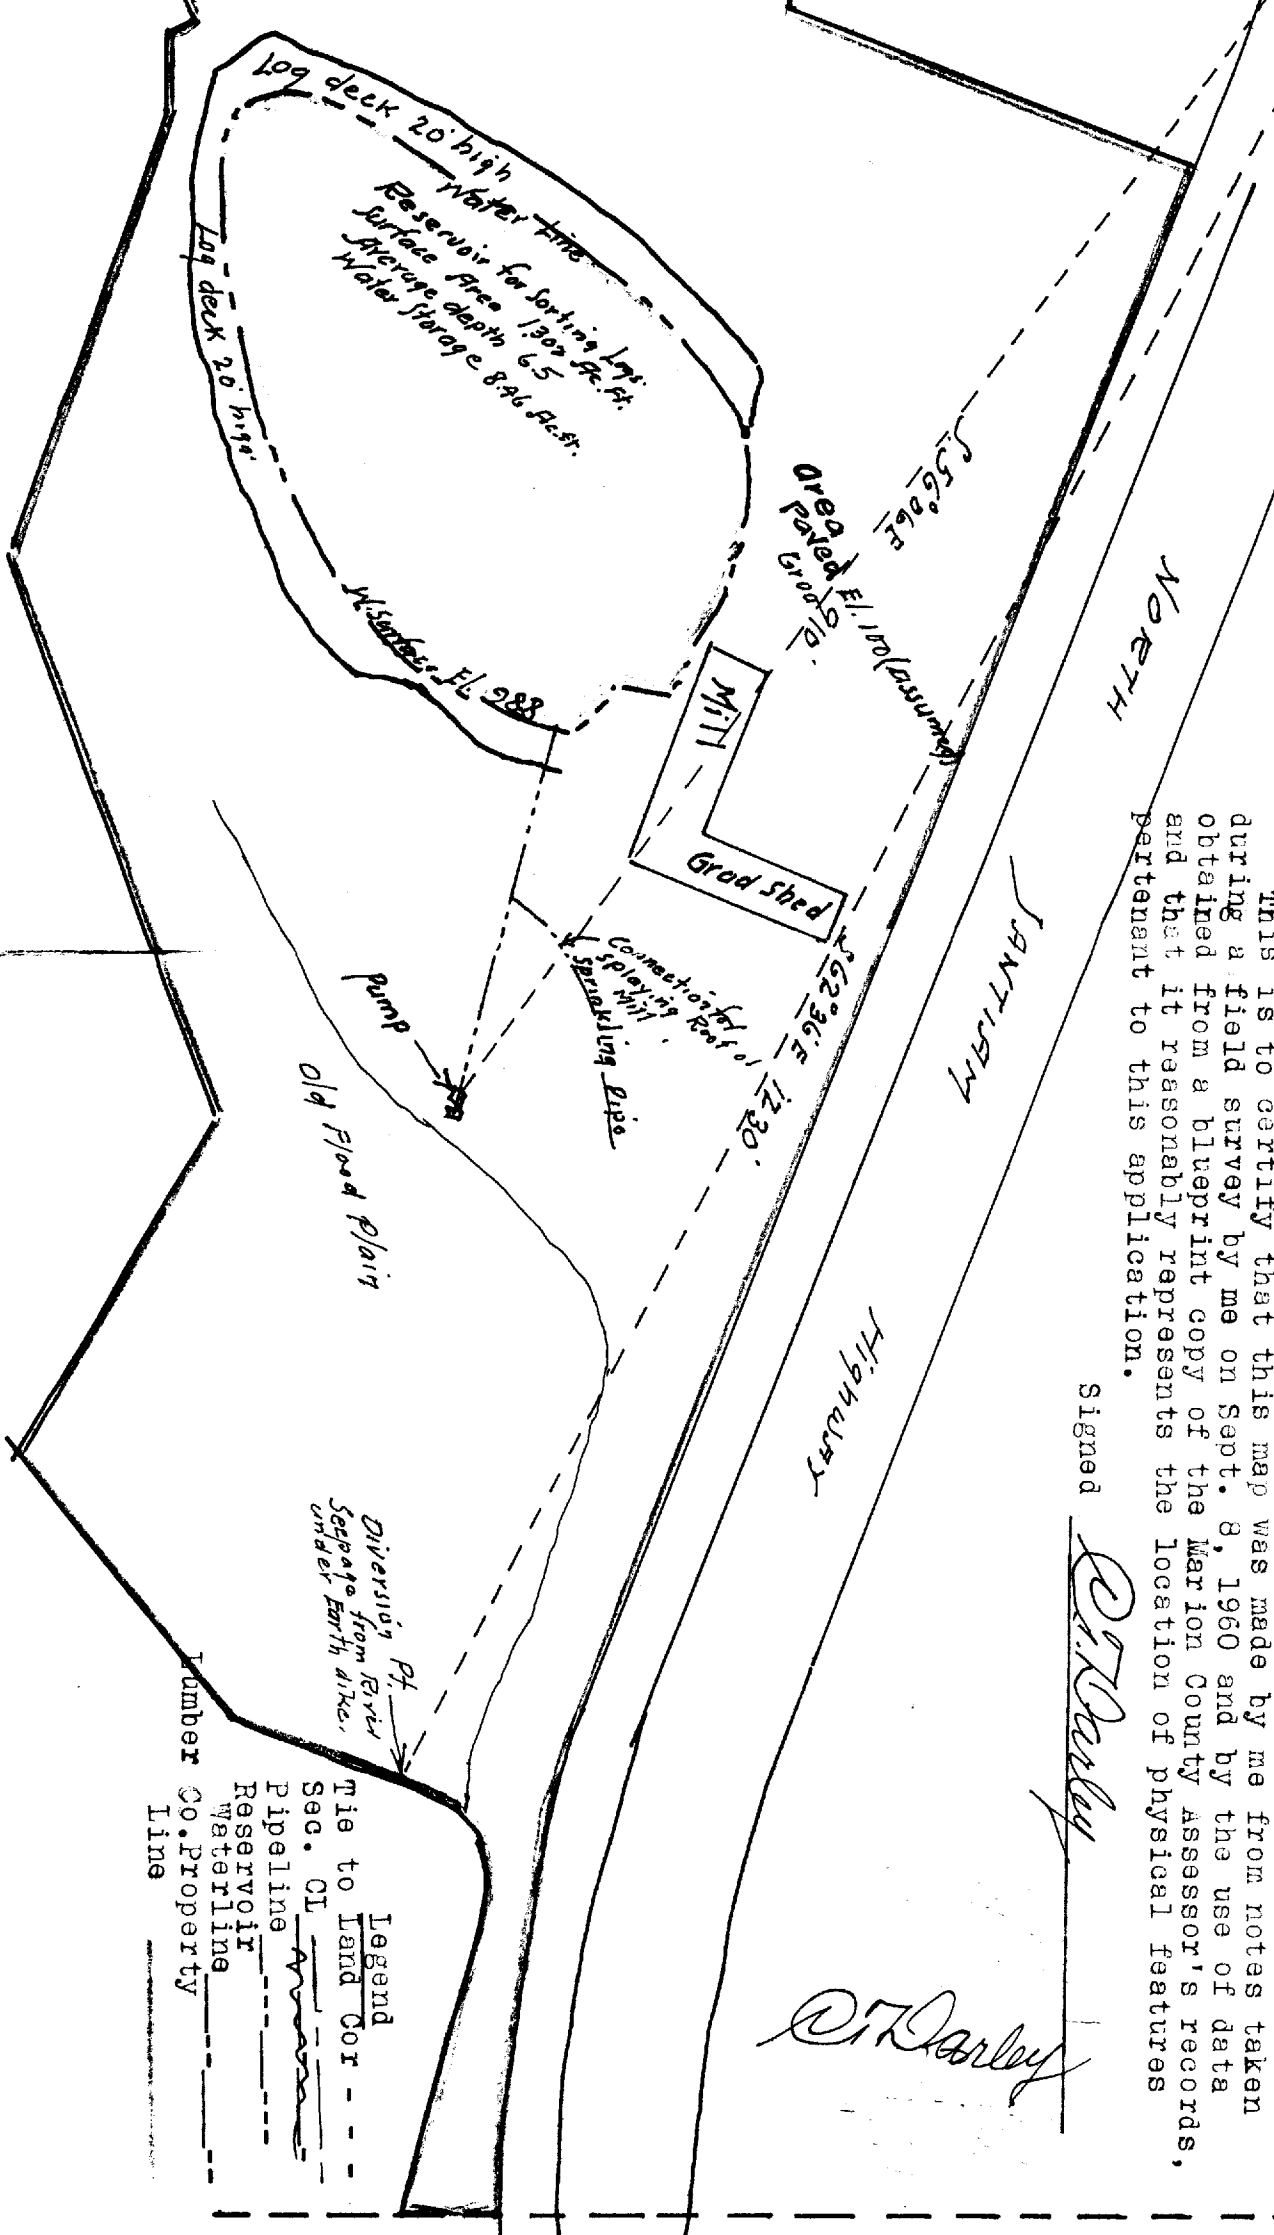

Legend
 Tie to Land Cor - - -
 Sec. CL Assessor
 Pipeline - - -
 Reservoir
 Waterline - - -
 Lumber Co. Property
 Line