


Per 23963
303/3

30/88
23963

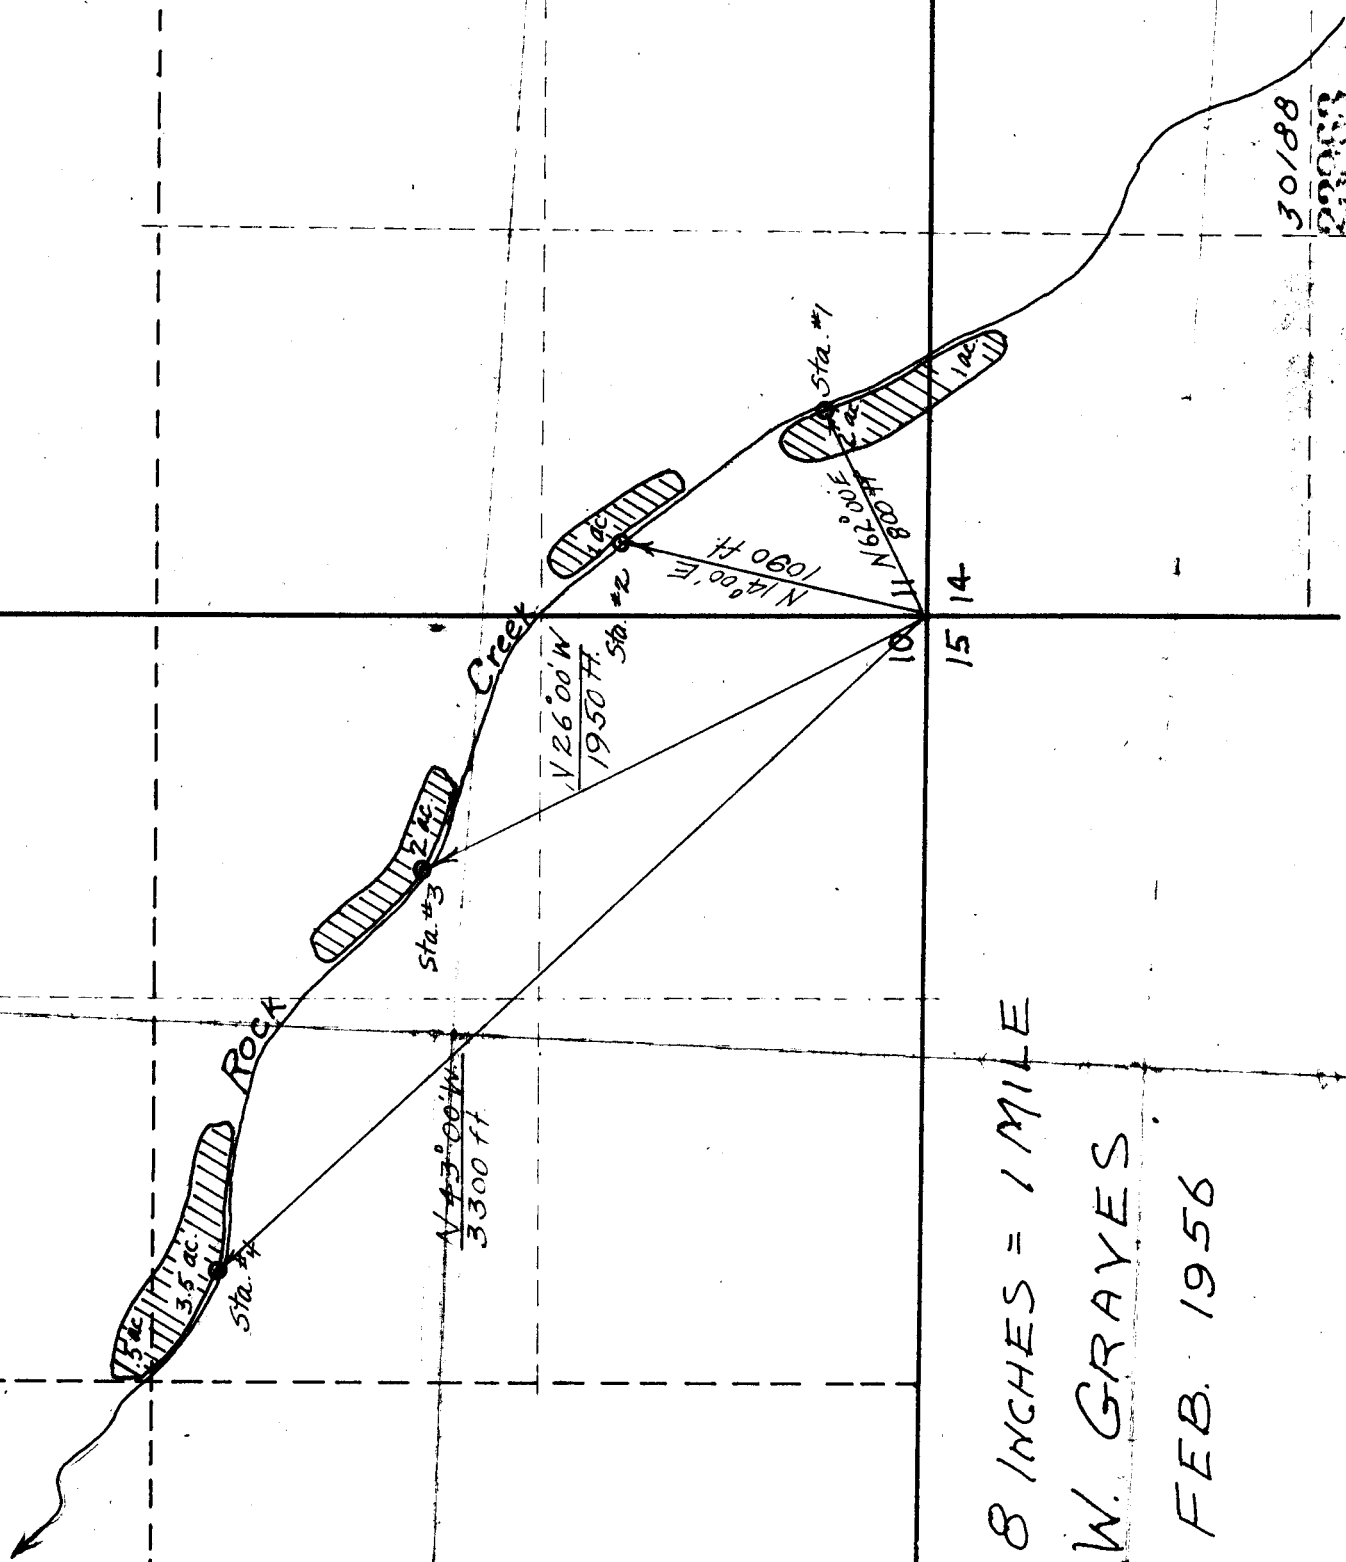

SCALE - 8 INCHES = 1 MILE

JOHN W. GRAYES

8 FEB. 1956

53.

R258

10