



Section 4

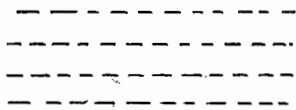

Township 1 S. Range 3 E.

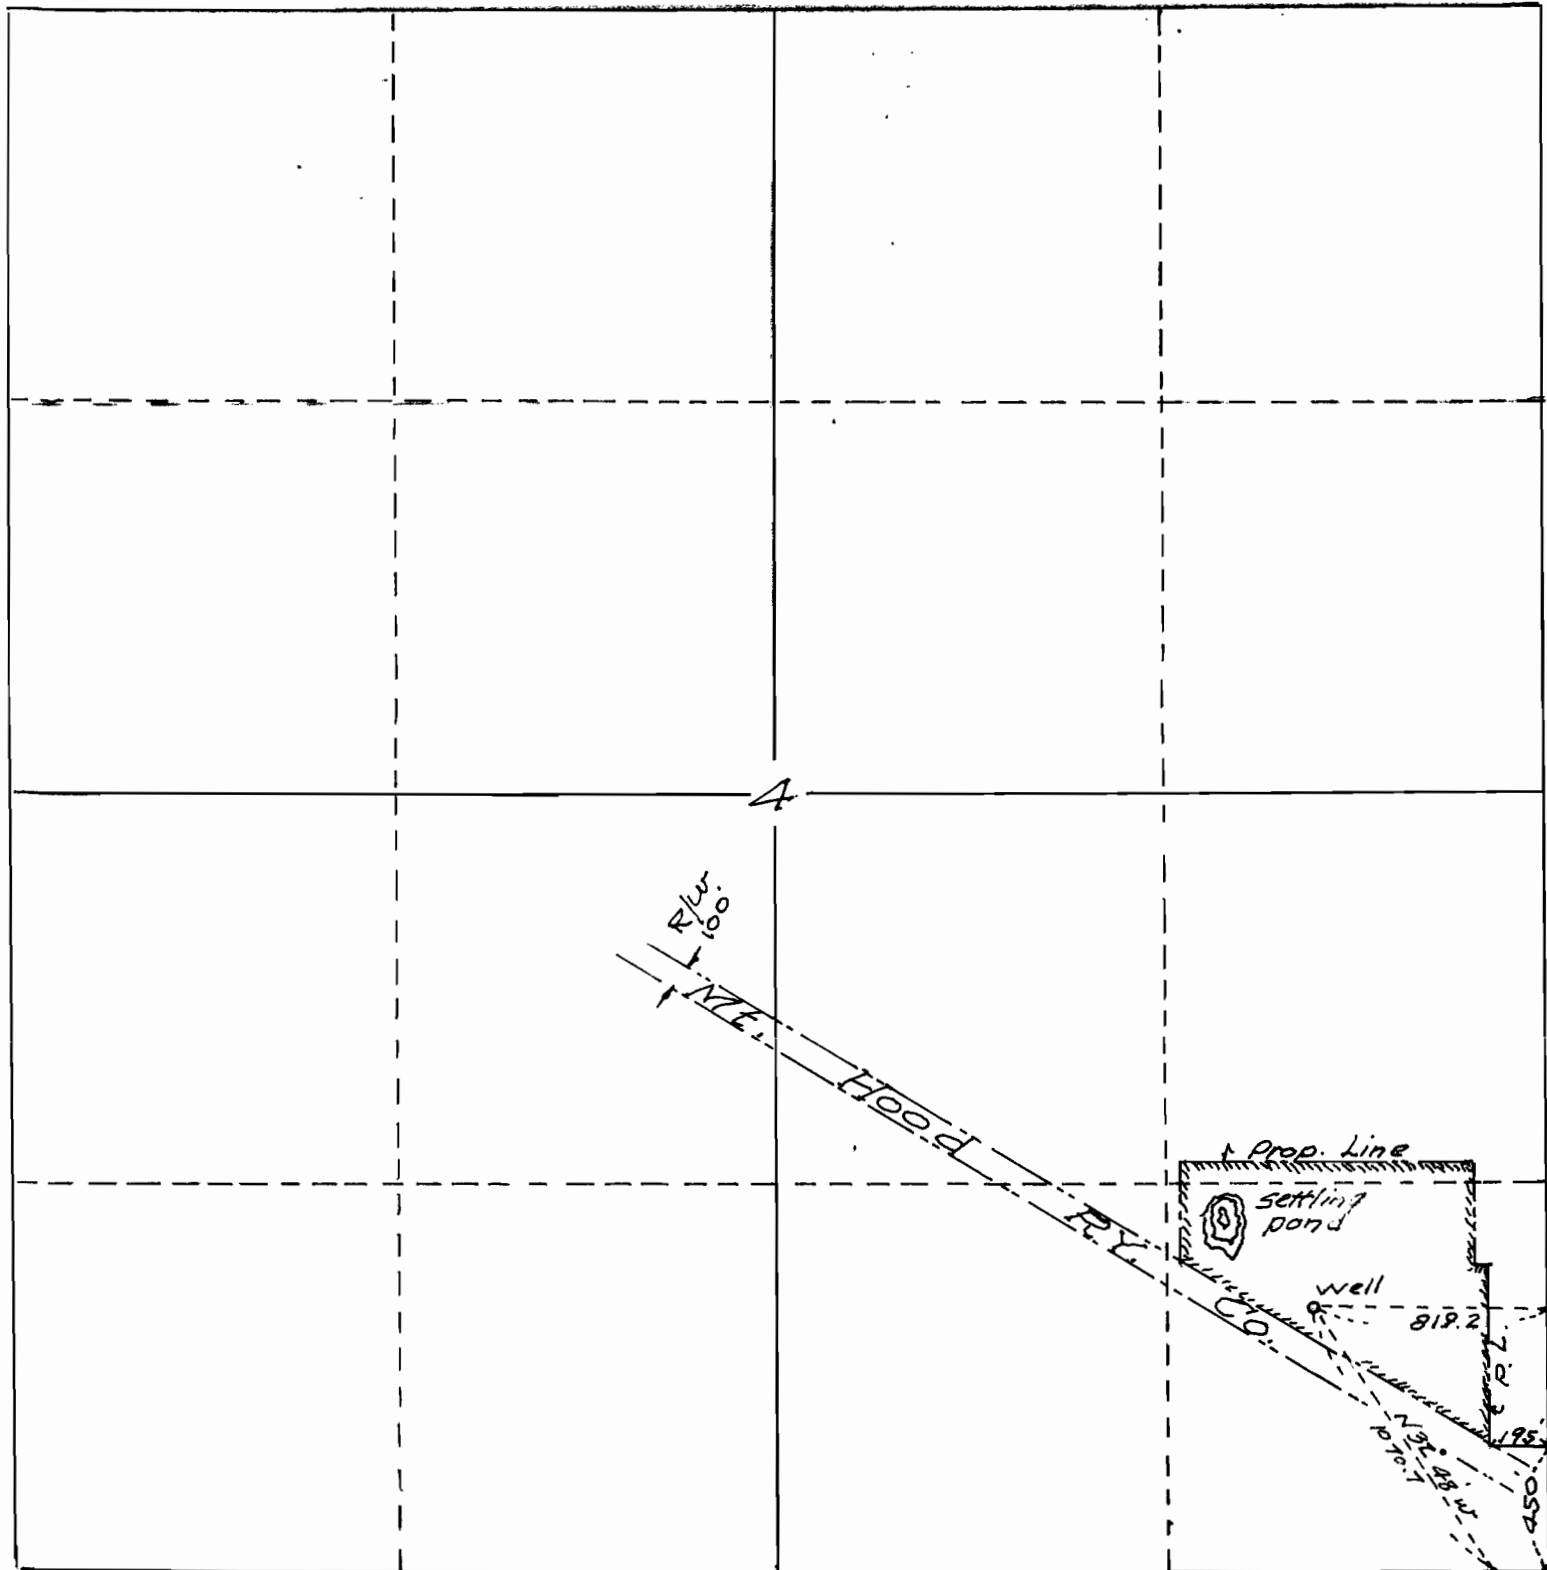

N



scale 1" = 1/8 mile

Application No. 1018  
Permit No. G-881

