


T.5S.R.10W.W.M

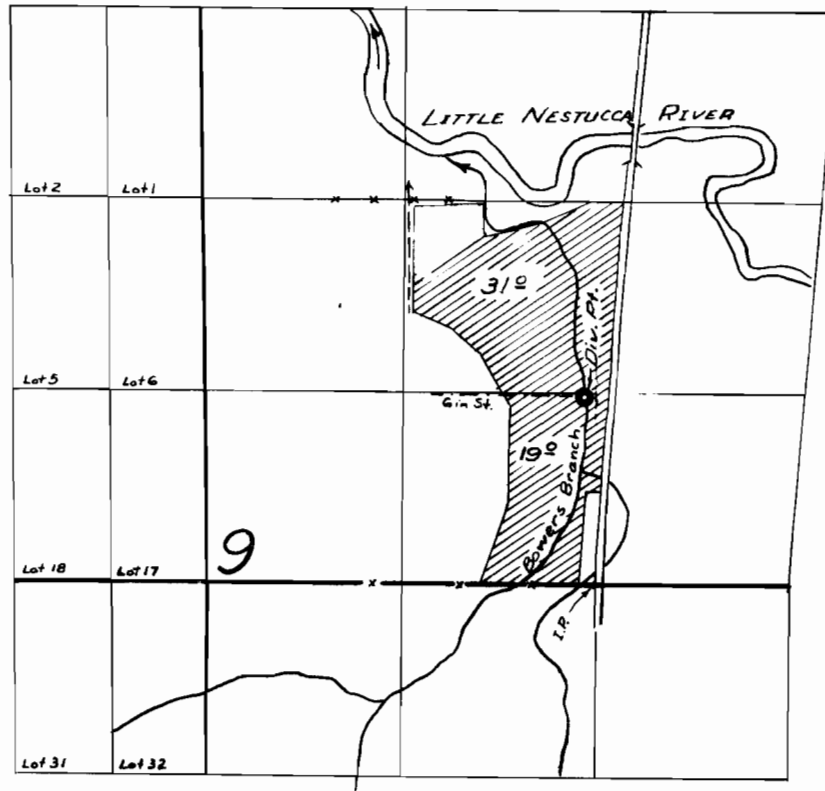

FINAL PROOF SURVEY
UNDER

Application No. 23669 Permit No. 18703
IN NAME OF

J. L. CRAVEN

Surveyed 30 AUG. 1957, by R. H. WHITBY