


T.5S.R.10W.W.M.

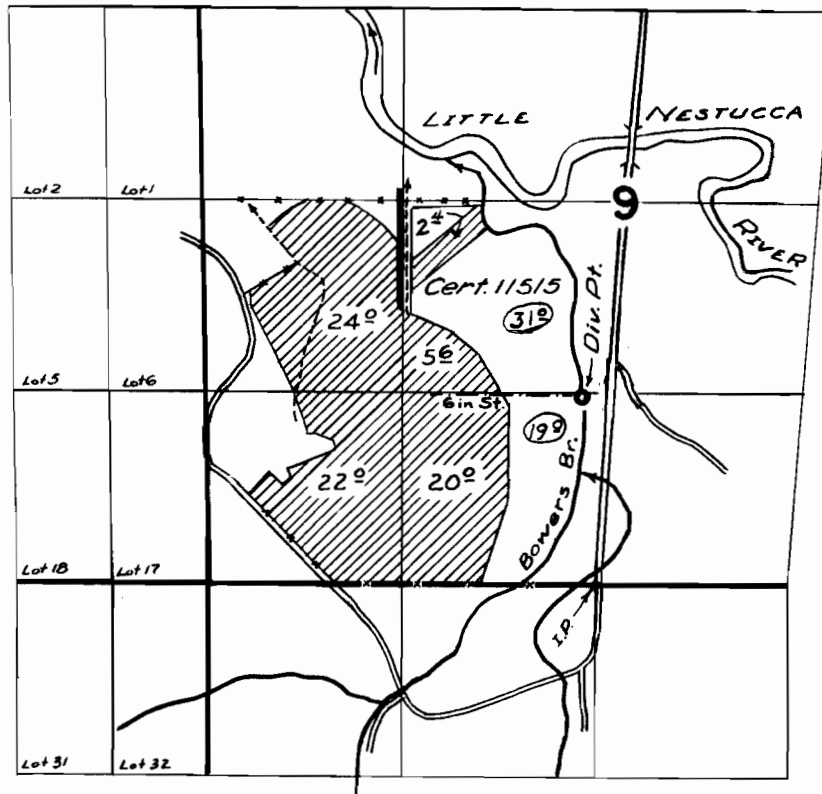

FINAL PROOF SURVEY
UNDER

Application No. 31944 Permit No. 25235
IN NAME OF

JOHN L. CRAVEN, JR.

Surveyed 30 June 1961, by m. A. Bish