


T.7S.R.4W.W.M.

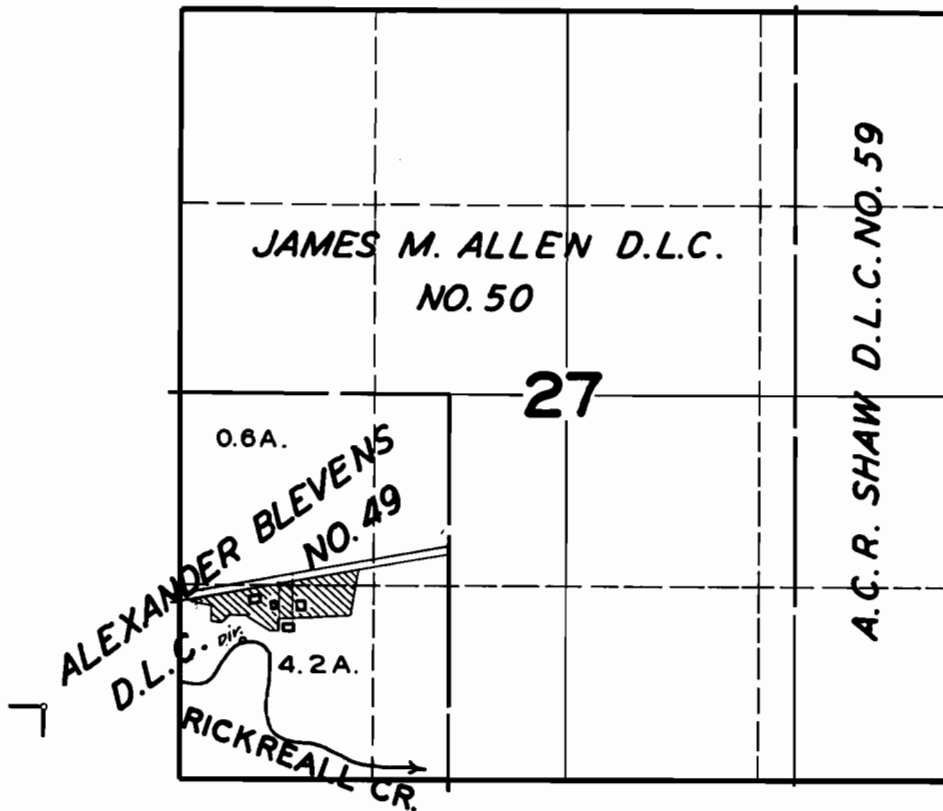

FINAL PROOF SURVEY

UNDER

Application No. 19522... Permit No. 15313.....

IN NAME OF

MRS. ELZA K. SPLANE

Surveyed SEP. 2, 1948, by JAS. E. BUNNELL