


# T.29S.R.12W.W.M.

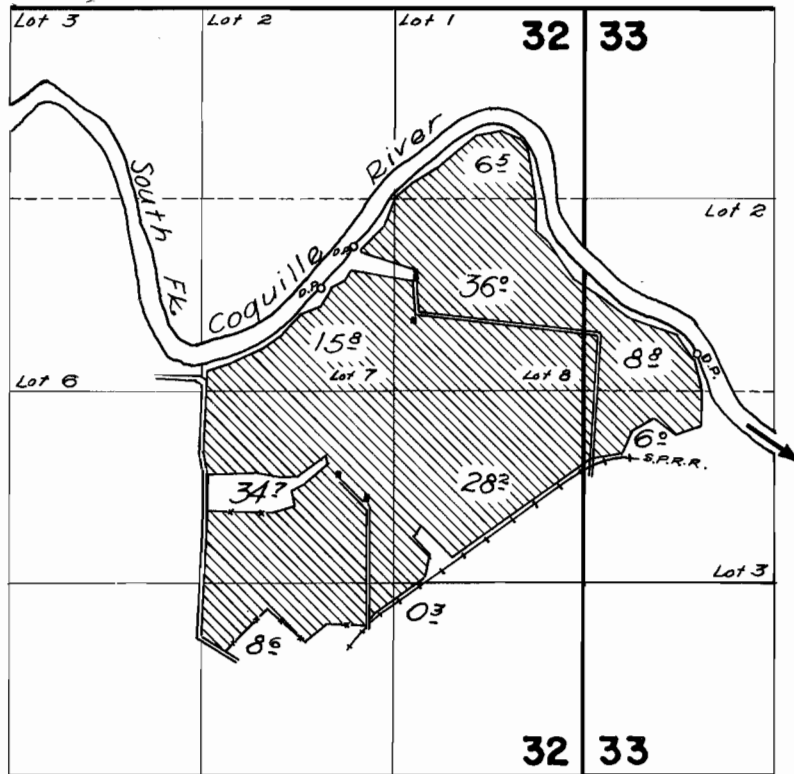

## FINAL PROOF SURVEY UNDER

Application No. **31536** ... Permit No. **24872** ...  
IN NAME OF

**Mrs. H. V. Neuhaus & Mrs. E. B. Eickmeyer**

Surveyed *August 8 1961*, by *C. O. Bartels*.