


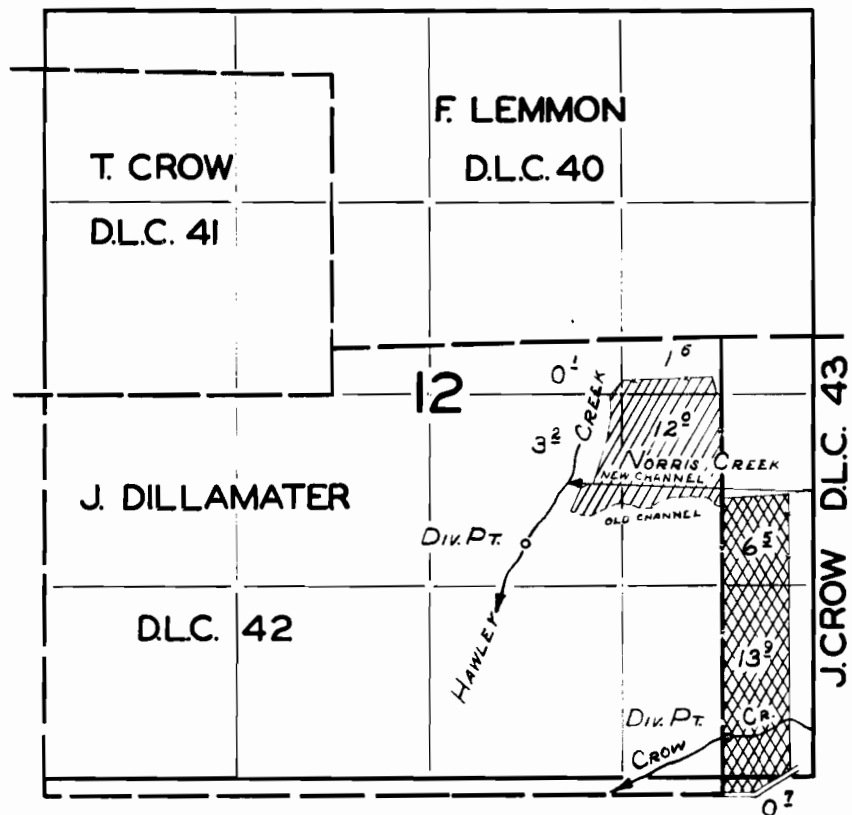

T.20S.R.5W.W.M.



FINAL PROOF SURVEY UNDER

Application No. 31839 Permit No. 25106 
 Application No. 31840 Permit No. 25106 
 IN NAME OF

DELWIN A. & JENNIE BETH DOUGHTY

Surveyed *Mar 25 1961*, by *M. BISH*