




# T.20S.R.5W.W.M.

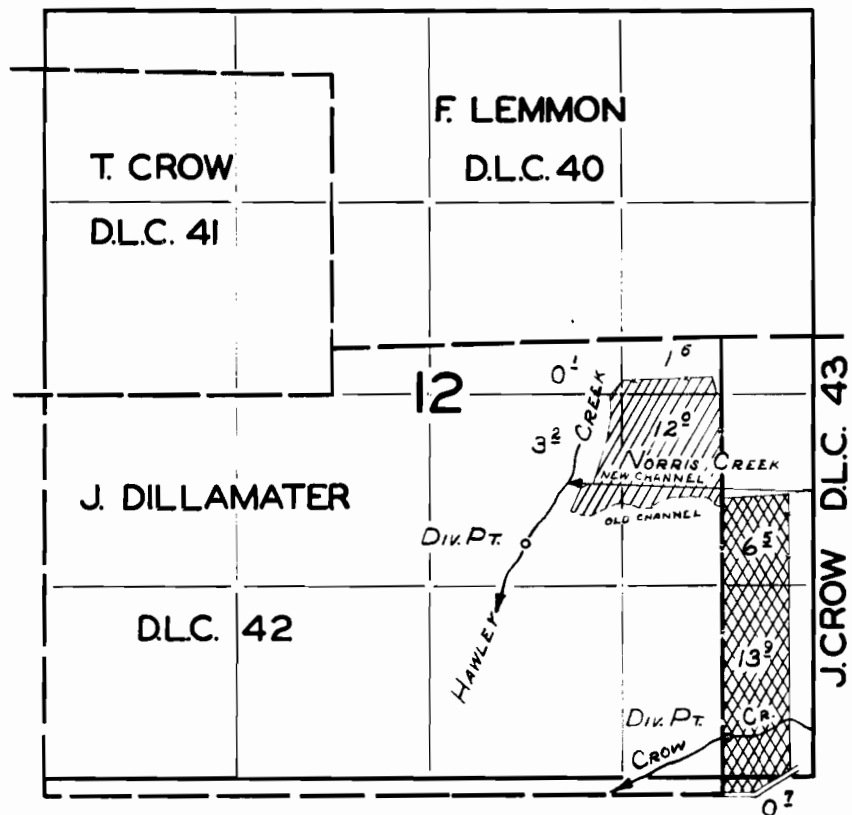

## FINAL PROOF SURVEY UNDER

Application No. 31839      Permit No. 25106        
 Application No. 31840      Permit No. 25106        
 IN NAME OF

**DELWIN A. & JENNIE BETH DOUGHTY**

Surveyed *Mar 25 1961*, by *M. BISH*