


T.17 S. R. 2 W. W.M.

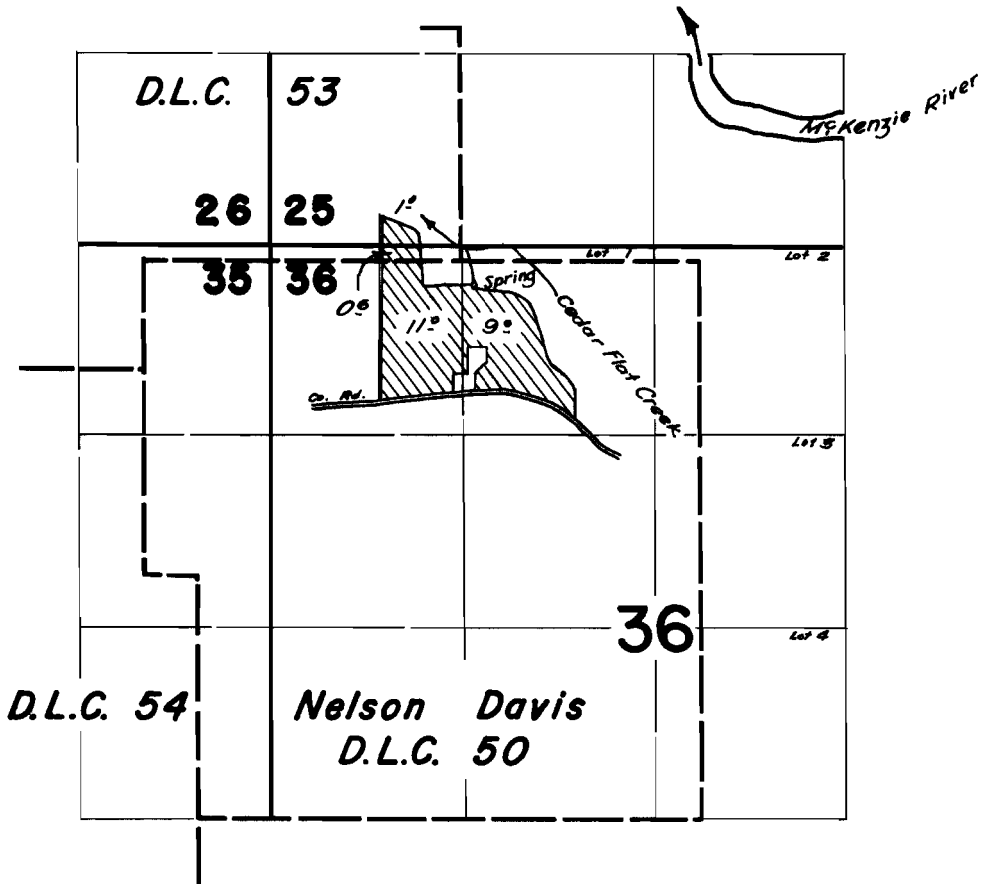

FINAL PROOF SURVEY
UNDER

Application No. 31938 Permit No. 25182
IN NAME OF

CHARLES E. PARK

Surveyed May 12 1961, by M. Bish

LF