


T.19S.R.6 W.W.M.

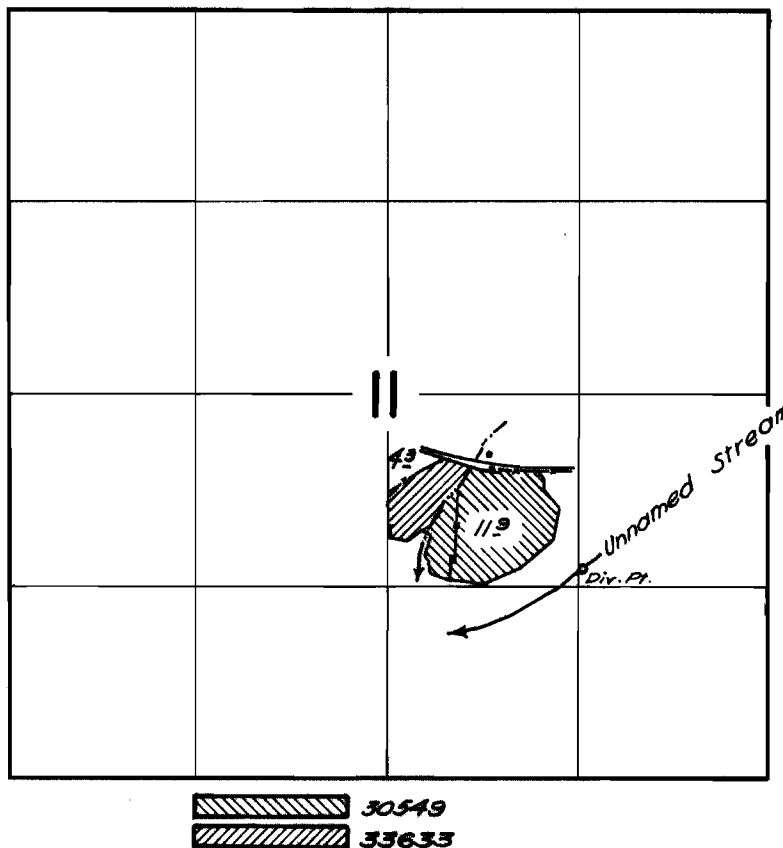

FINAL PROOF SURVEY
UNDER

Application No. **30549** Permit No. **24054**
33633 **26616**
IN NAME OF

BENJAMIN F. & ROSE N. MANGOLD

Surveyed *May 25* 1961, by *L. Jackson*