


T. 9 S. R. 3 W. W. M.

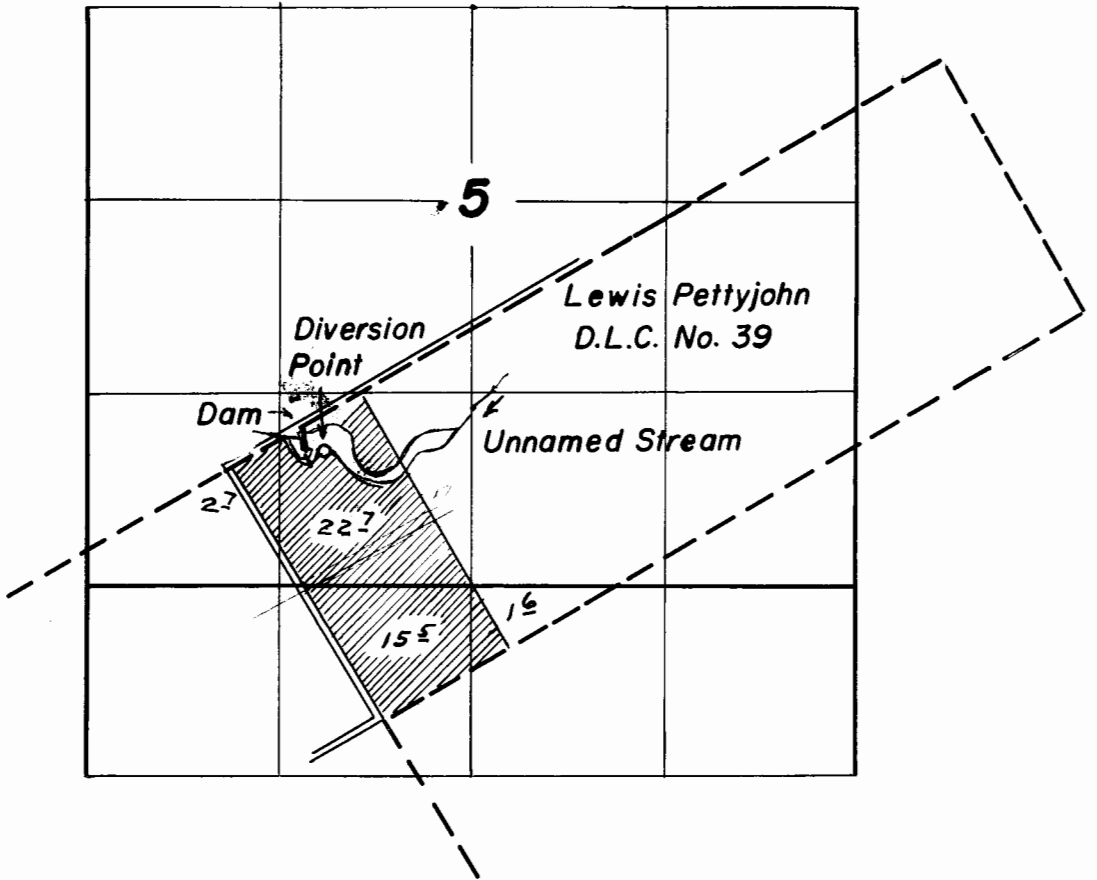

FINAL PROOF SURVEY
UNDER

Application No. 31648 Permit No. 25024
R-31647 R-2050
IN NAME OF

James L. Payne

Surveyed 29 June 1962, by Floyd L. Sigmond