




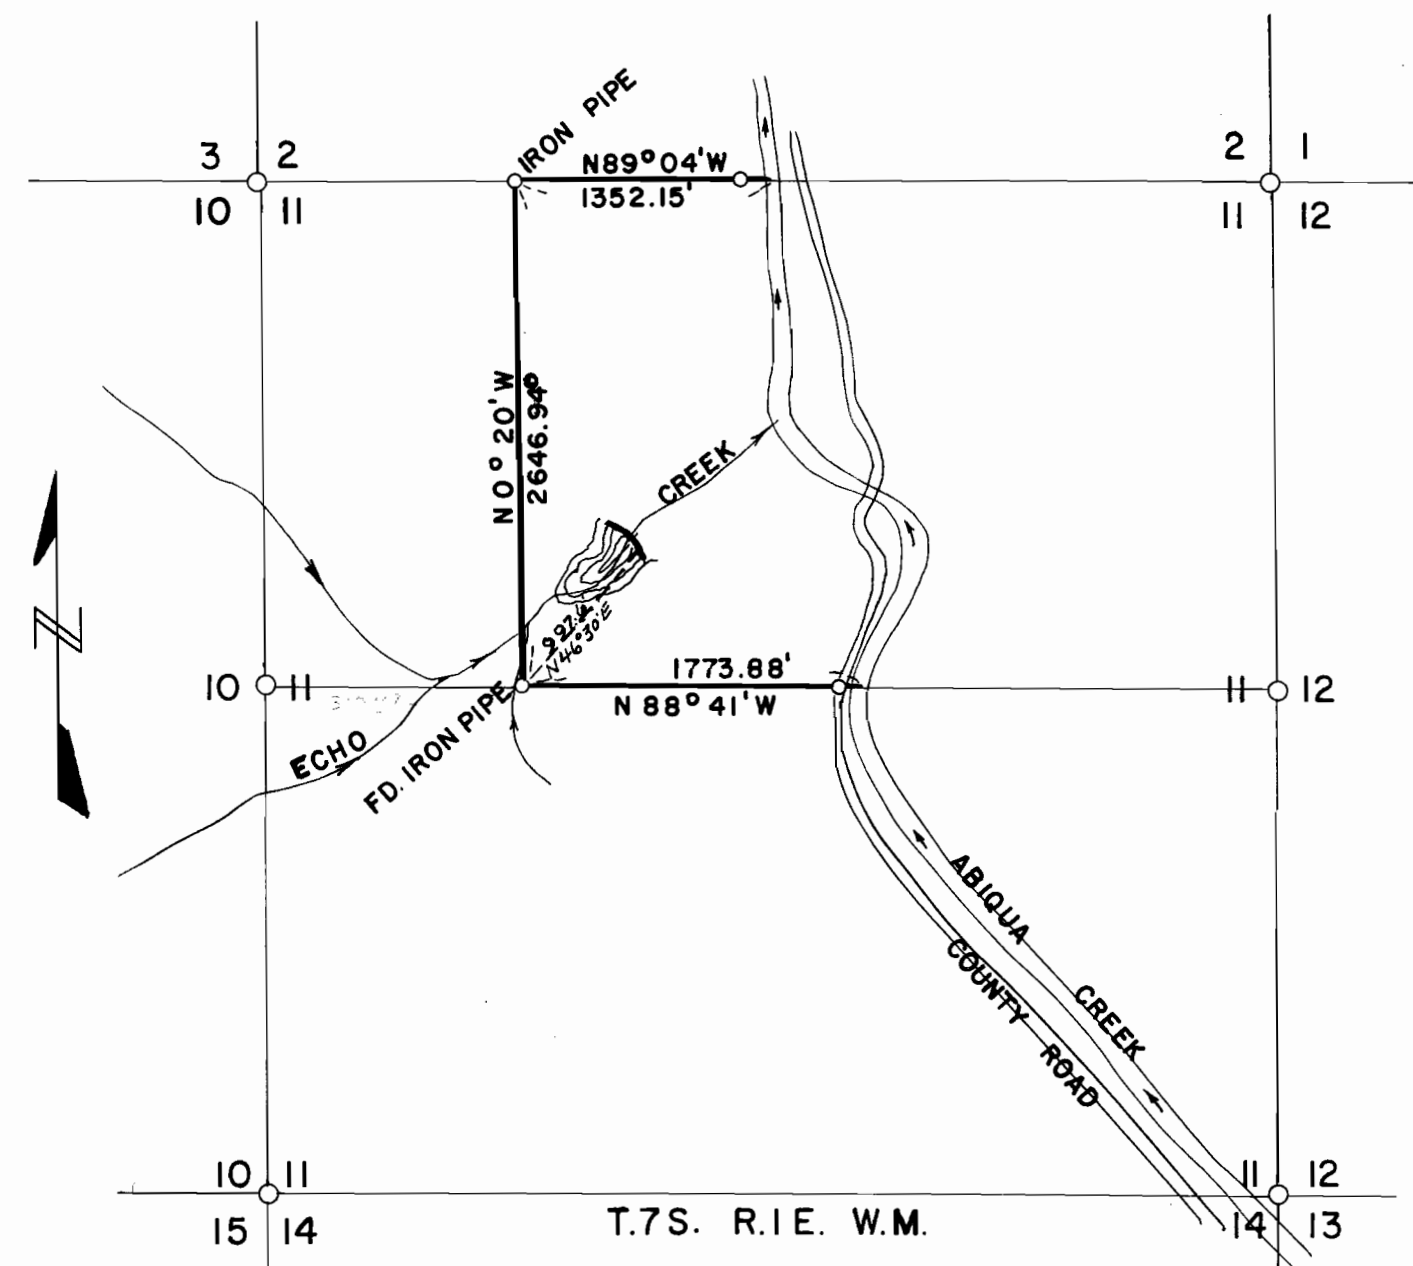

LOCATION MAP
SCALE 1" = 1000'
(NOTE: SEE MARION COUNTY SURVEY NO. 1410
FOR PROPERTY CORNER DATA)

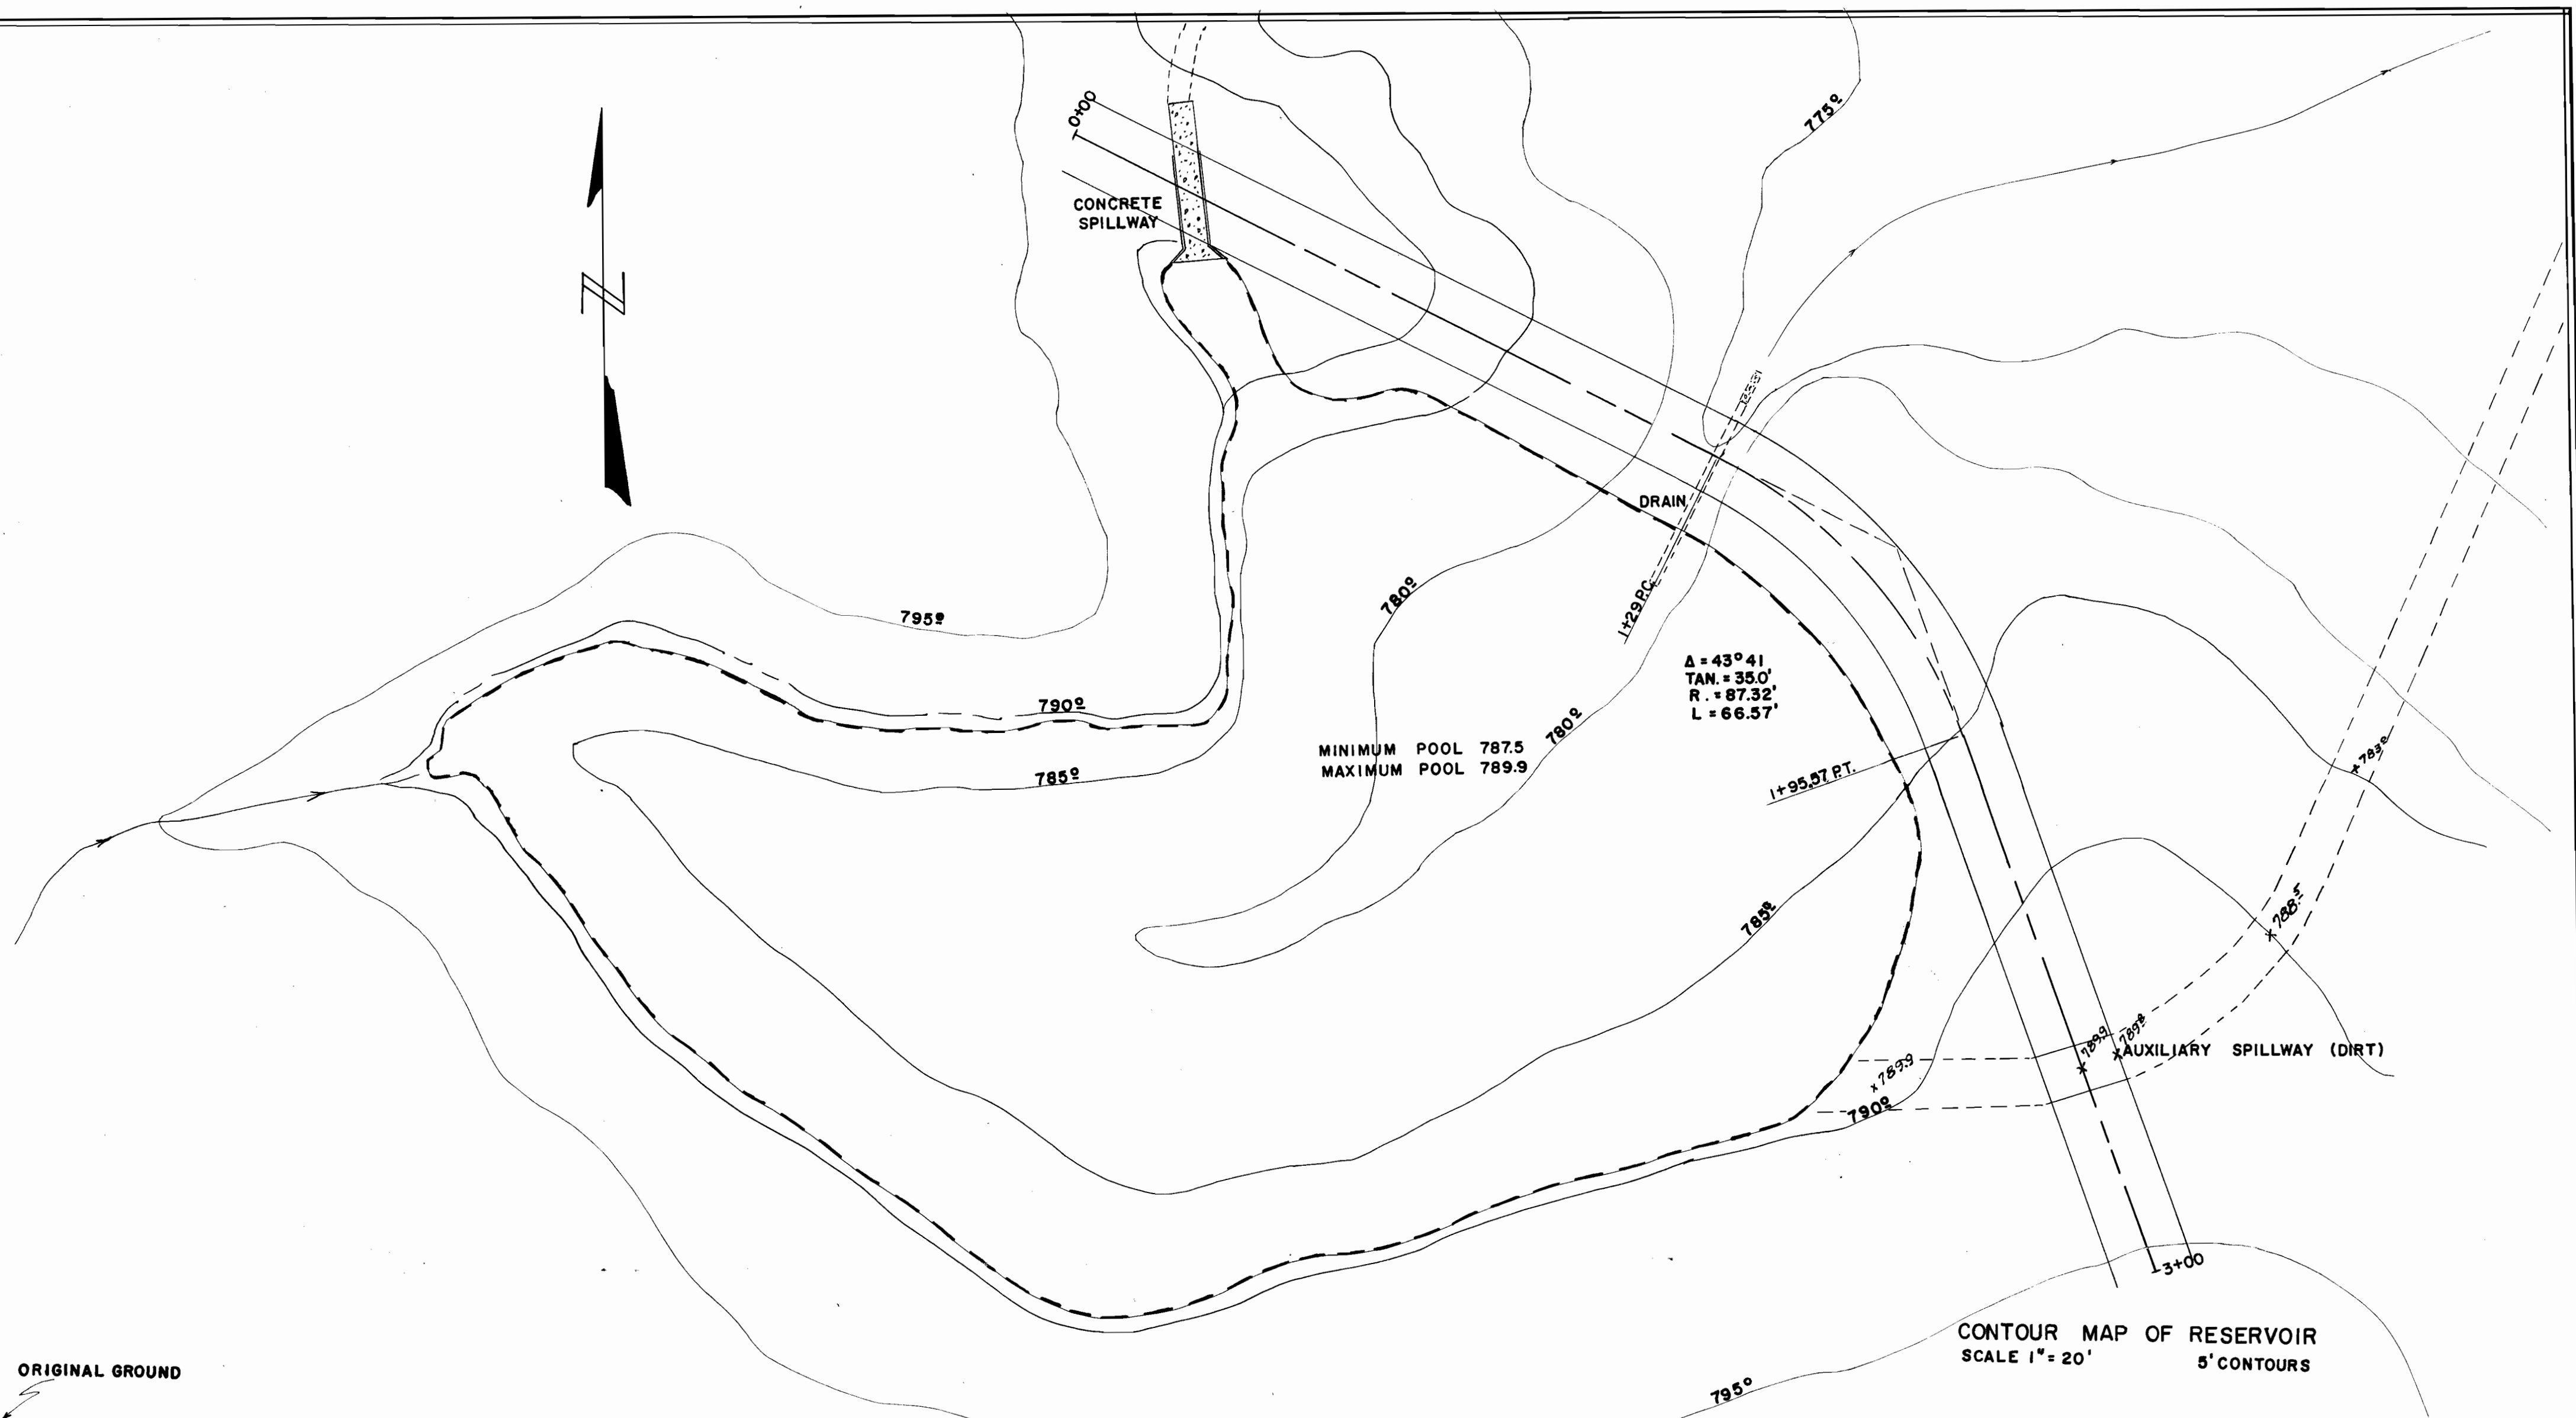


CONTOUR MAP OF RESERVOIR
SCALE 1" = 20'
5' CONTOURS

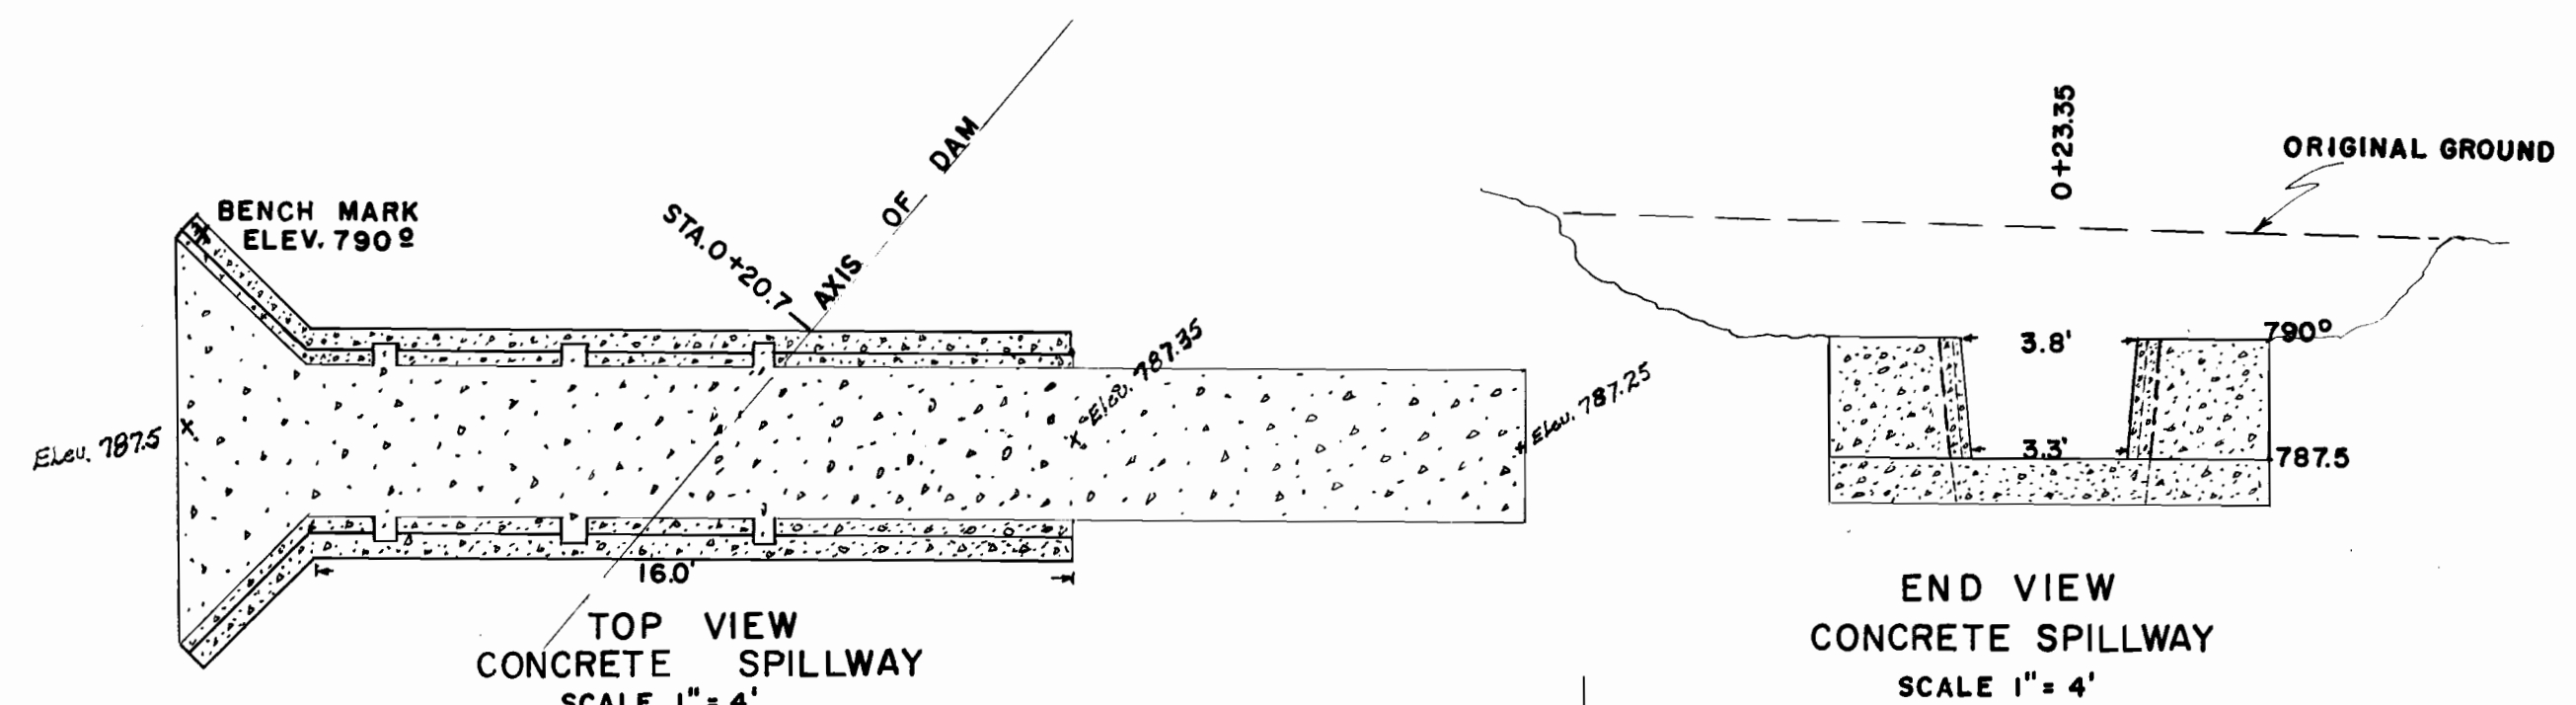


TOP VIEW
CONCRETE SPILLWAY
SCALE 1" = 4'

END VIEW
CONCRETE SPILLWAY
SCALE 1" = 4'

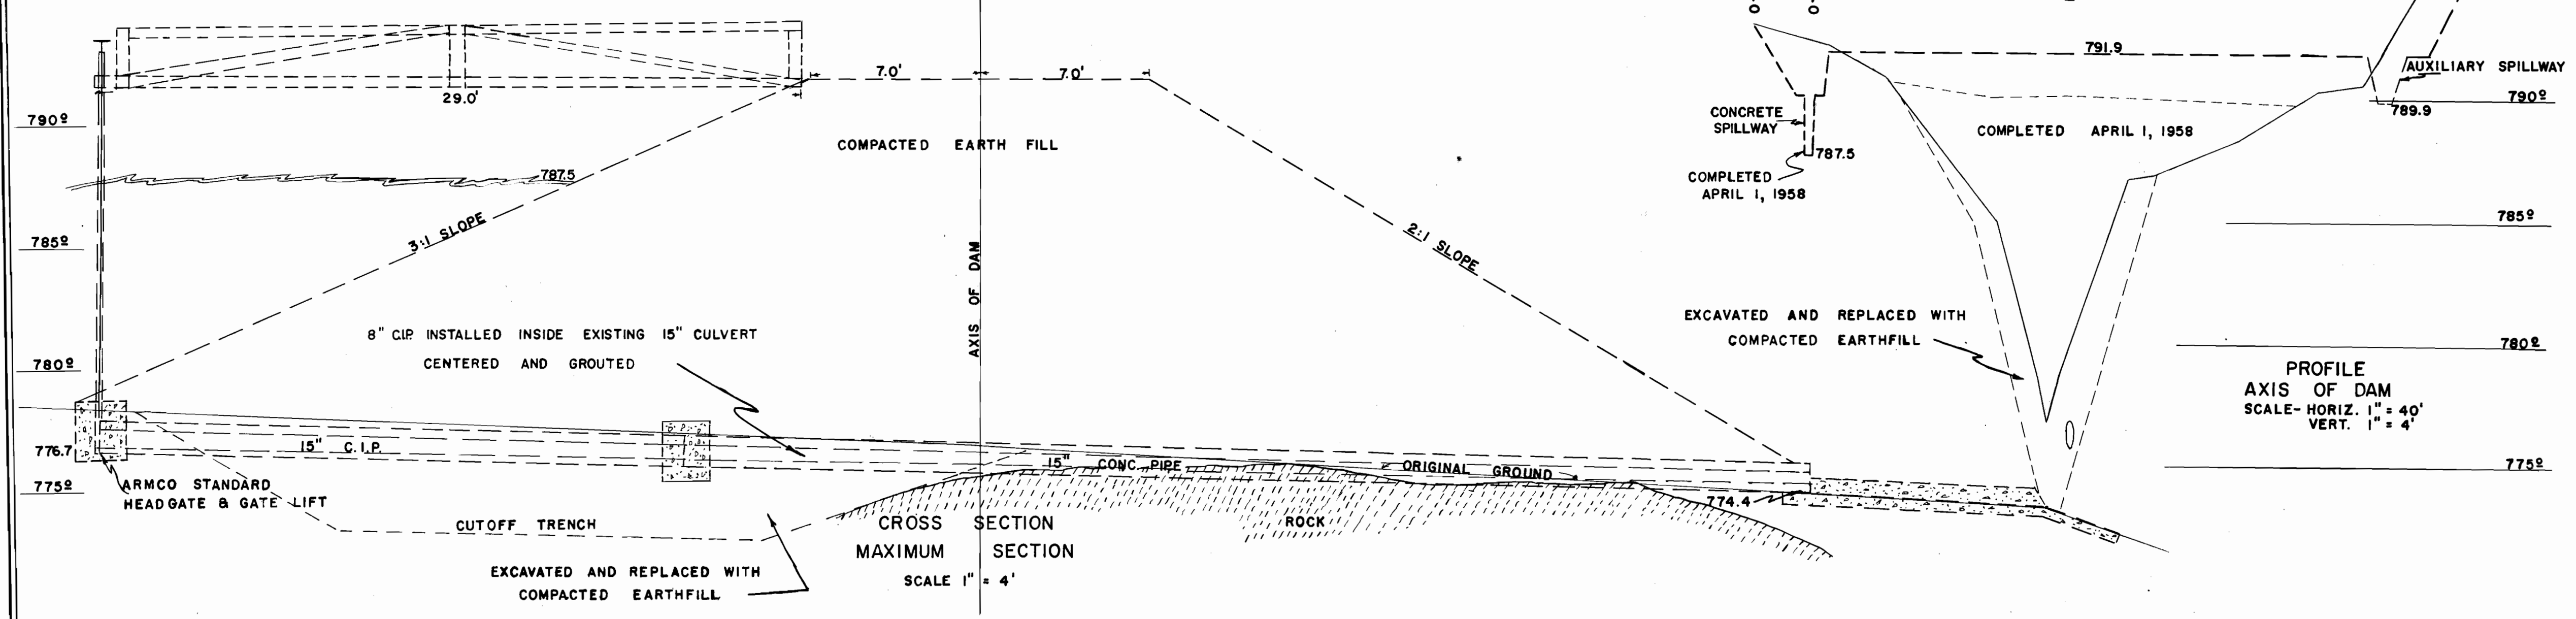

CROSS SECTION
MAXIMUM SECTION
SCALE 1" = 4'

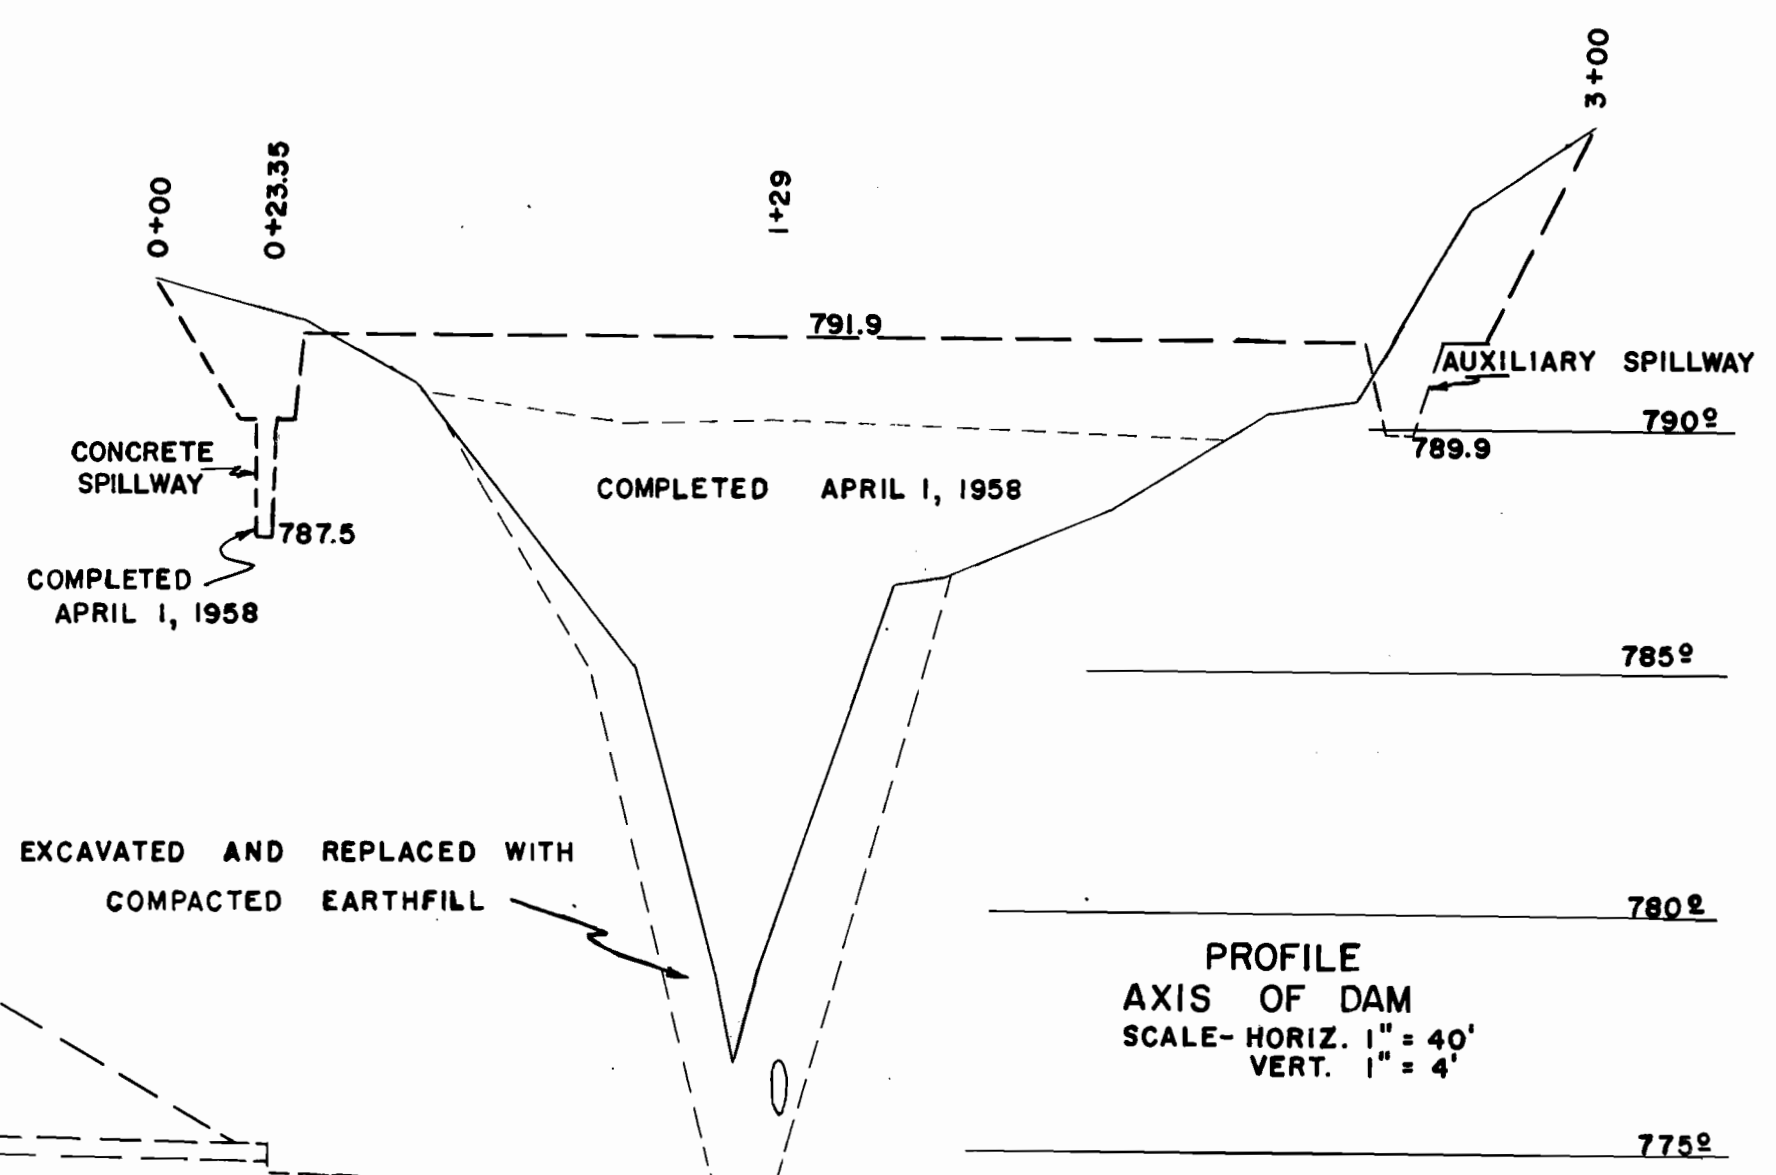

PROFILE
AXIS OF DAM
SCALE- HORIZ. 1" = 40'
VERT. 1" = 4'

I, GEORGE L. GRIFFIN, OF LEBANON, OREGON, DO HEREBY
CERTIFY THAT THIS MAP WAS MADE FROM NOTES TAKEN
DURING AN ACTUAL SURVEY MADE BY ME (OR UNDER MY
IMMEDIATE SUPERVISION) ON MARCH 26, 1958.

George L. Griffin
REG. PROFESSIONAL CIVIL ENGINEER (OREGON)

Dec. 28 57
George L. Griffin
ENGINEER

JAMES W. BARTON'S
ECHO PARK RESERVOIR
Application No. R-32105 & 32106
Permit No. R-2292 & 26442

SCALE	DATE APRIL 18, 1958	SHEET 1 of 1
DR. <i>SDS</i> CK	SHAW, DOBYNS & ASSOCIATES, INC. FORESTRY, ENGINEERING, SURVEYING SWEET HOME, OREGON	DWG. NO. SD. 39

George L. Griffin