

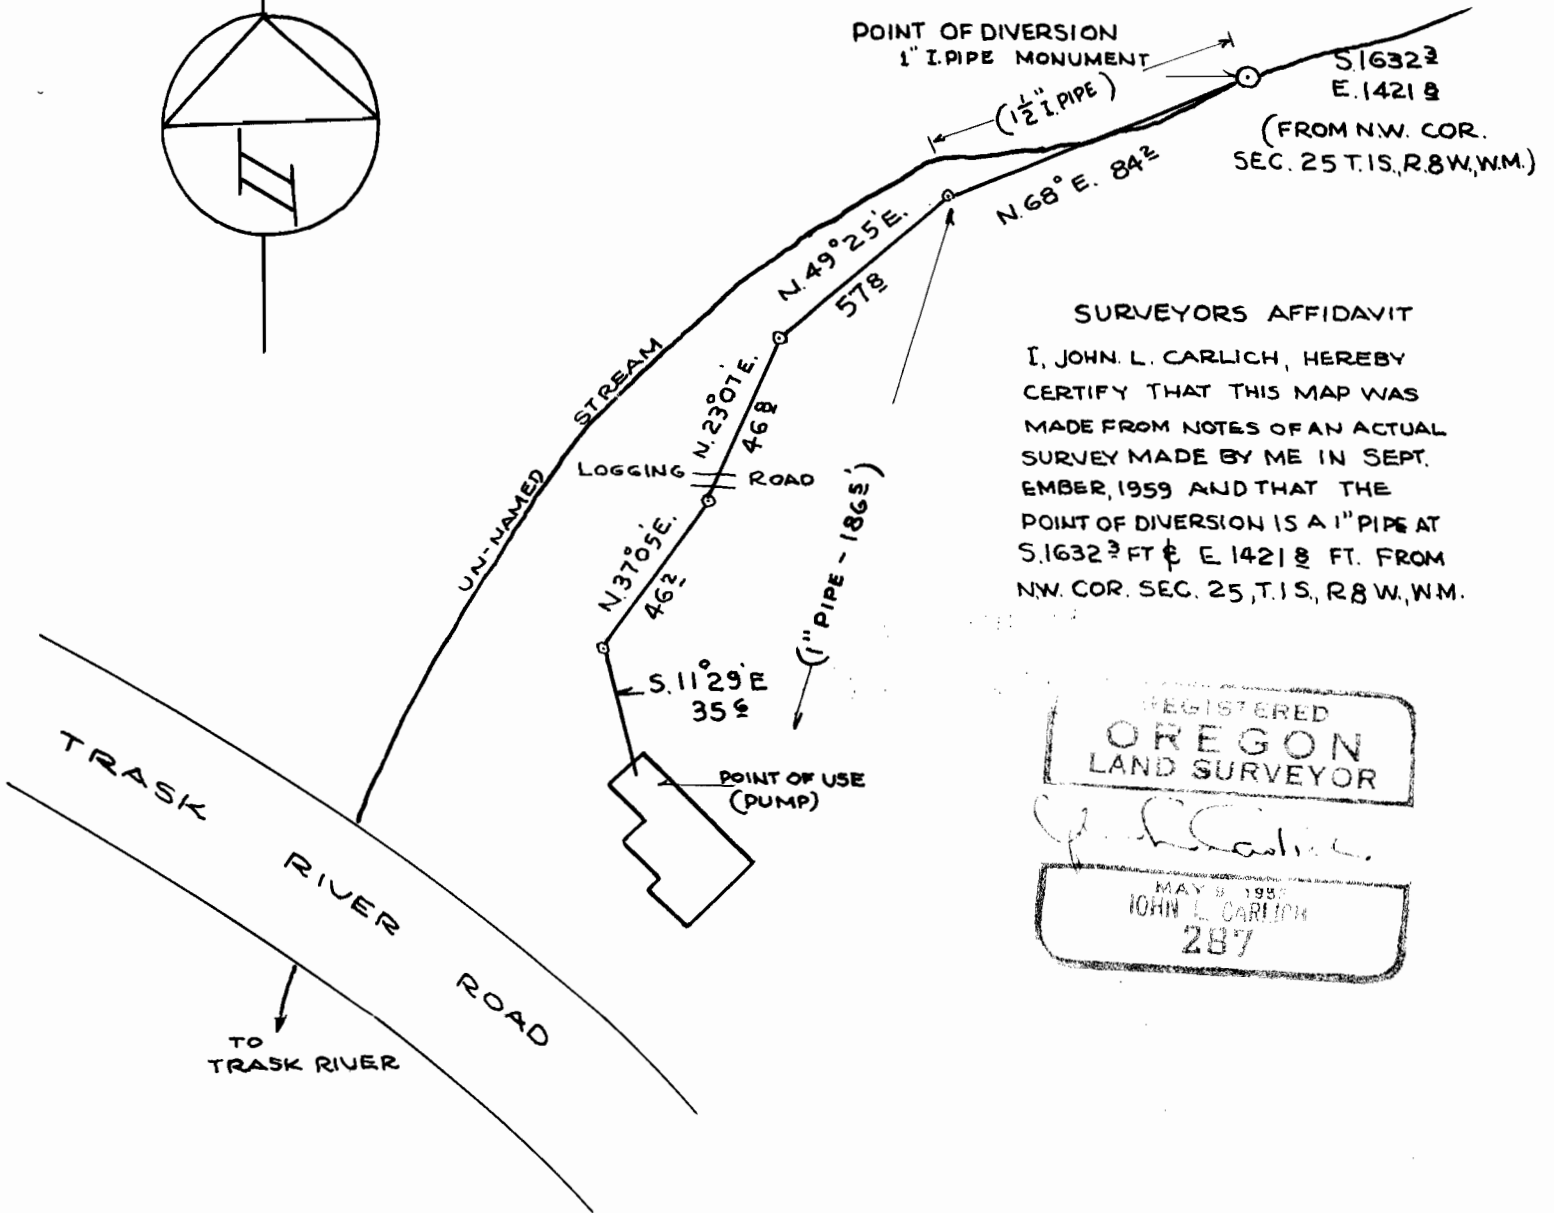


DETAIL MAP
SCALE 1" = 50 FEET

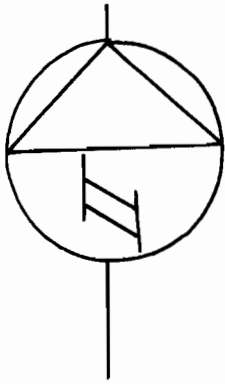


SURVEYORS AFFIDAVIT
I, JOHN L. CARLICH, HEREBY
CERTIFY THAT THIS MAP WAS
MADE FROM NOTES OF AN ACTUAL
SURVEY MADE BY ME IN SEPT.
EMBER, 1959 AND THAT THE
POINT OF DIVERSION IS A 1" PIPE AT
S. 1632³ FT & E. 1421⁸ FT. FROM
NW. COR. SEC. 25, T. 1 S., R. 8 W., W.M.

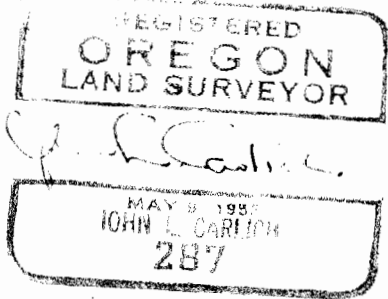

Application No. 33237
Permit No. 26336

VICINITY MAP
SCALE 1" = 1000 FEET

23 24
26 25

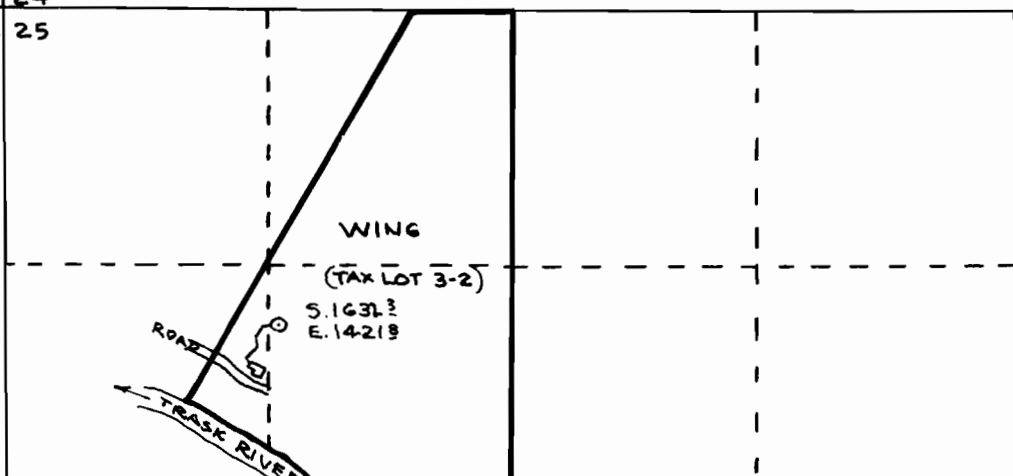

SURVEY MAP
FOR
M. J WING
WATER RIGHT APPLICATION
IN
NW⁴ SEC. 25 T. 1 S., R. 8 W., W.M.
SEPTEMBER, 1959