


# SURVEYORS CERTIFICATE

I, W. E. Anderson of Tillamook, Oregon do hereby certify that this map was made from notes taken during an actual survey made by me on February 19, 1960, and that it correctly represents the works herein.

W. E. Anderson

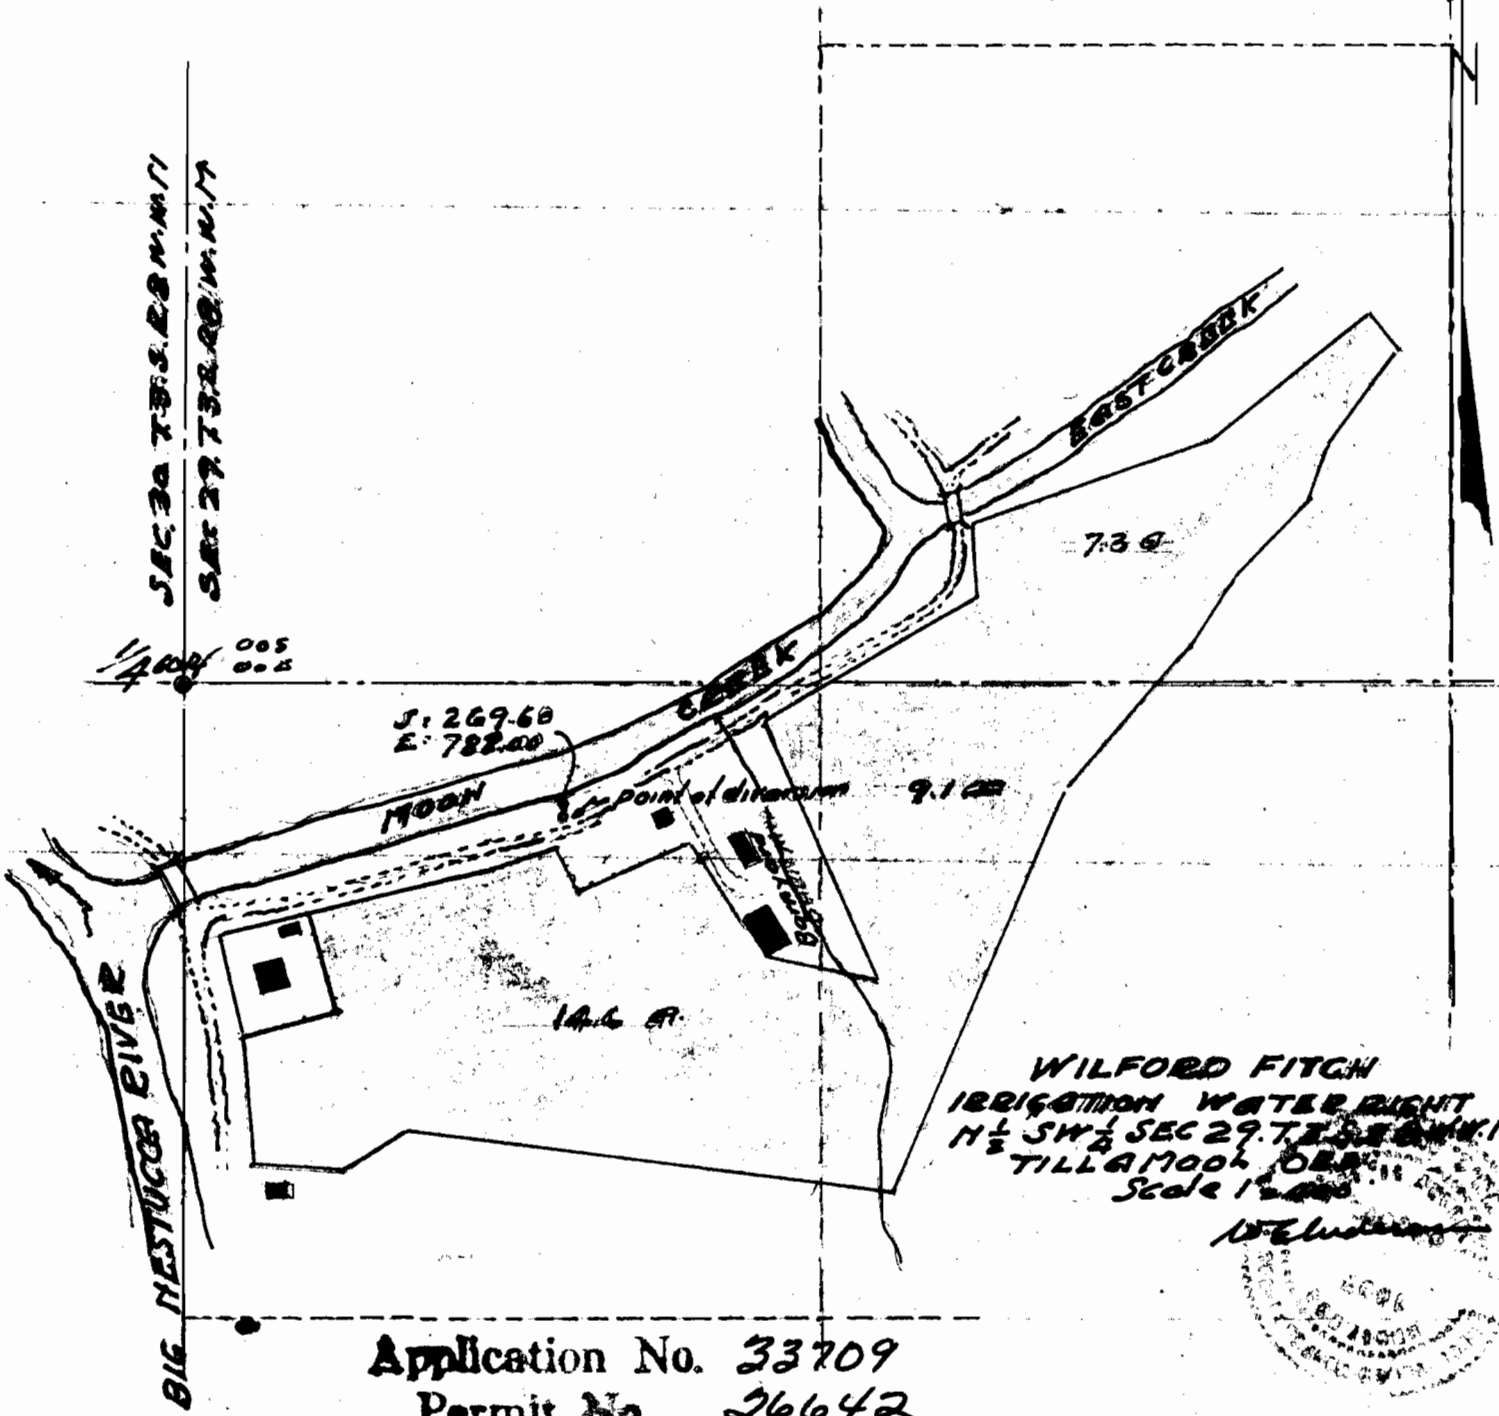

Application No. 33709  
Permit No. 26642

