
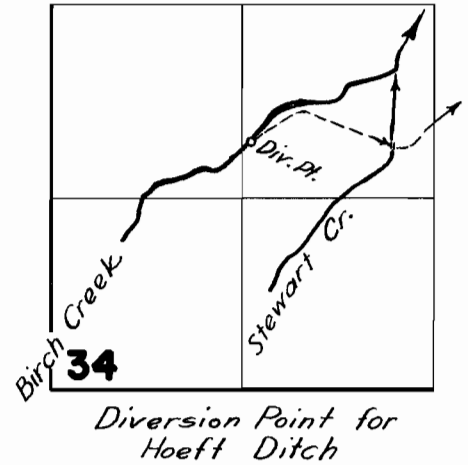


# T. IN. R. 32 E. W. M.

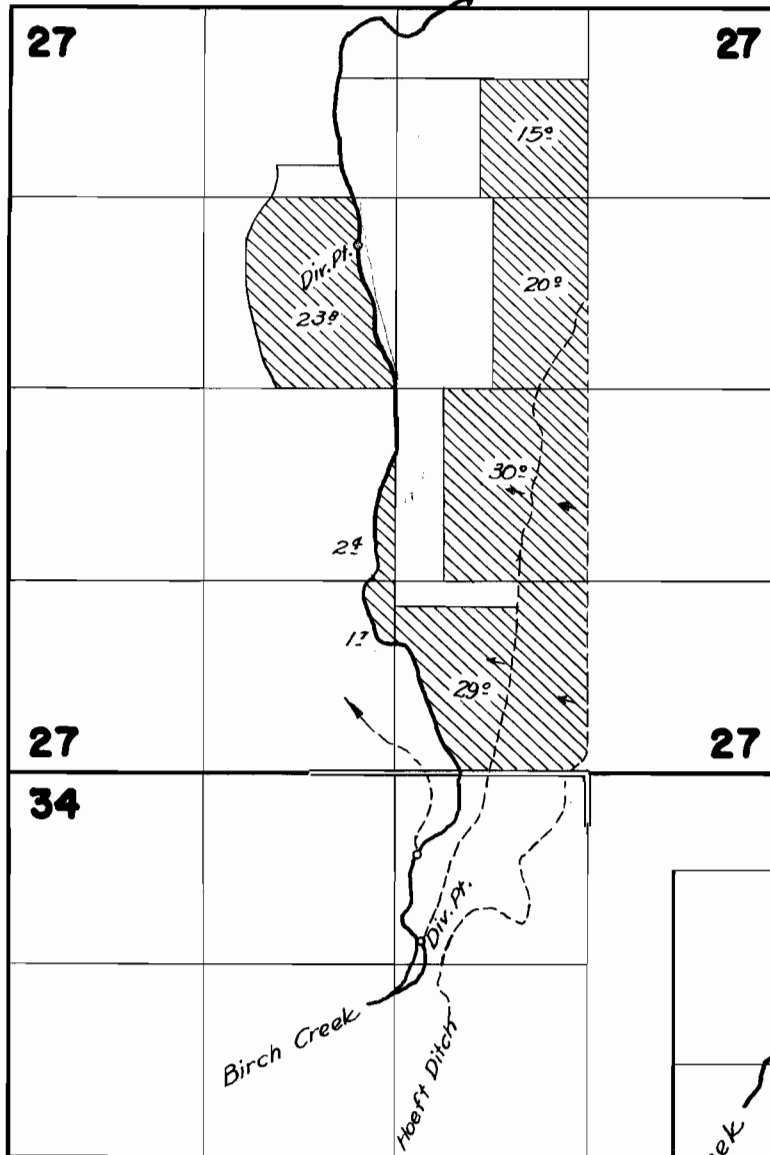


## FINAL PROOF SURVEY UNDER

Application No. **31327**... Permit No. **24830**...  
IN NAME OF

**EDWIN HOEFT**

Surveyed July 18 1960, by *A. J. Johnson*  
Sept. 18 1961, by *C. O. Bartels*

# T.1N.R.32E.W.M.

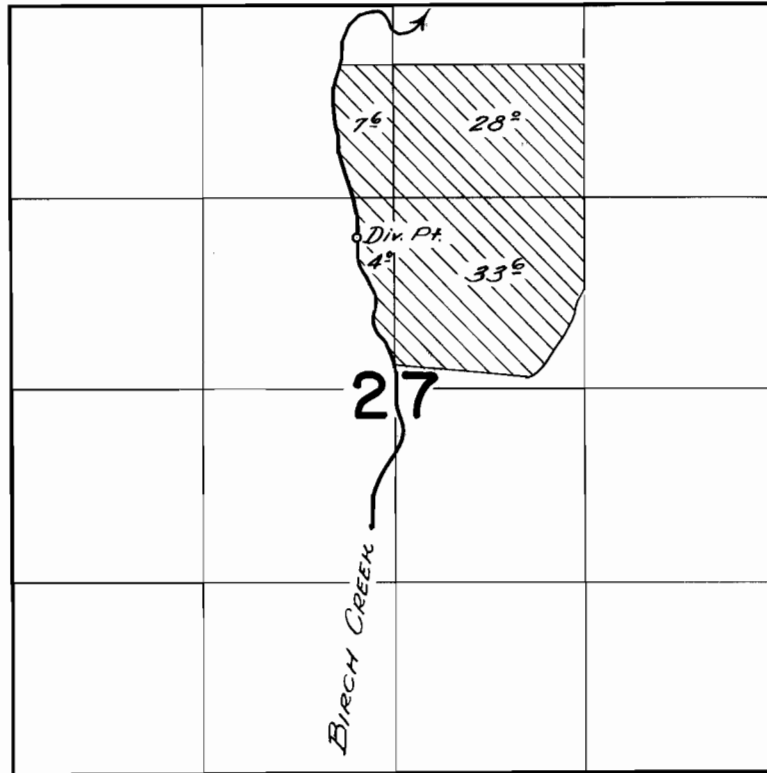

## FINAL PROOF SURVEY UNDER

Application No. 31327.. Permit No. 24830..  
IN NAME OF

..... EDWIN HOEFT .....

Surveyed Sept. 18, 1961, by C.B. Bartels .....