

SUNSET RD.

WHITE PINE RD.

BEAVERTON-HILLSDALE HIGHWAY

JESUIT HIGH SCHOOL

8" WELL, DRILLED & CASED

N 55° 33' E
800.1 FT.

N 73° 11' W
1318.6 FT.

S 87° 53' W 1923.3 FT.



LAURELWOOD DRIVE

STONE, NE COR
THOS. DENNY DLC # 47

2" IRON PIPE, 1/4 SEC
COR 14 13, T15 RIW WM


SURVEY FOR
SOCIETY OF JESUS

WELL LOCATION

IN SEC 14 T15 RIW WM NEAR BEAVERTON,
WASHINGTON COUNTY, OREGON.

SURVEY MADE 28 SEPT. 1957
SCALE: 1" = 200'

Application No. G-893
Permit No. G-781

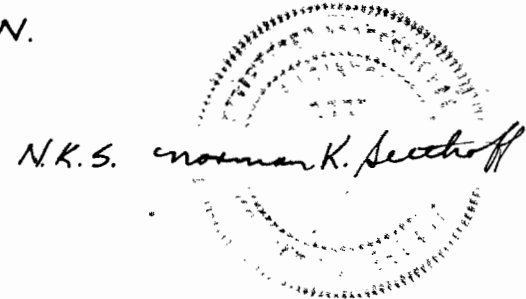

MAR 21 1958
STATE ENGINEER
N.K.S.

IRRIGATED AREAS

////// SW 1/4 OF NE 1/4 SEC 14 T15 RIW WM 11 AC.
//// SE 1/4 OF NE 1/4 SEC 14 T15 RIW WM 19 AC. 19.9 AC.

IRRIGATION SHOWN 18 MAR '58 NKS