
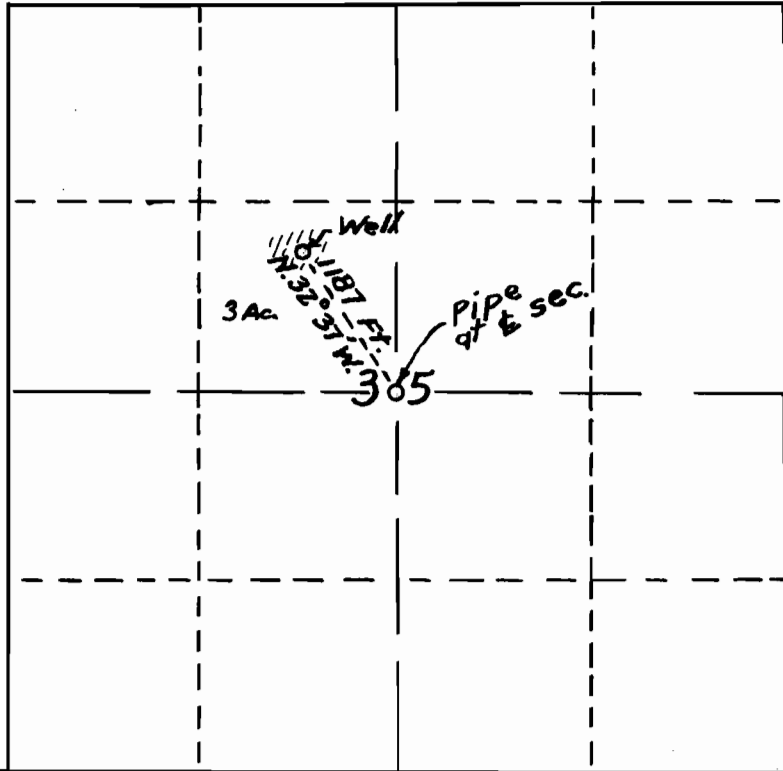


Map to accompany application  
By Sam Walter to appropriate water.  
Scale: 4 in. = 1 Mile

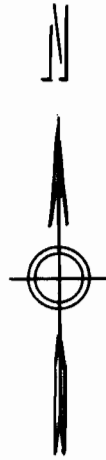

T.I.N.R.I.W.  
T.I.S.R.I.W.

Application No. G-1210  
Permit No. G-1065

I, O. Stoehr of Portland Ore, do hereby  
certify that on Oct. 2, 1958 I made the  
survey of the tie line to the well location  
hereon shown.

O. Stoehr

Registered Prof. Engr. #1089, Ore.



0-5129-5