


TIS R3WWM

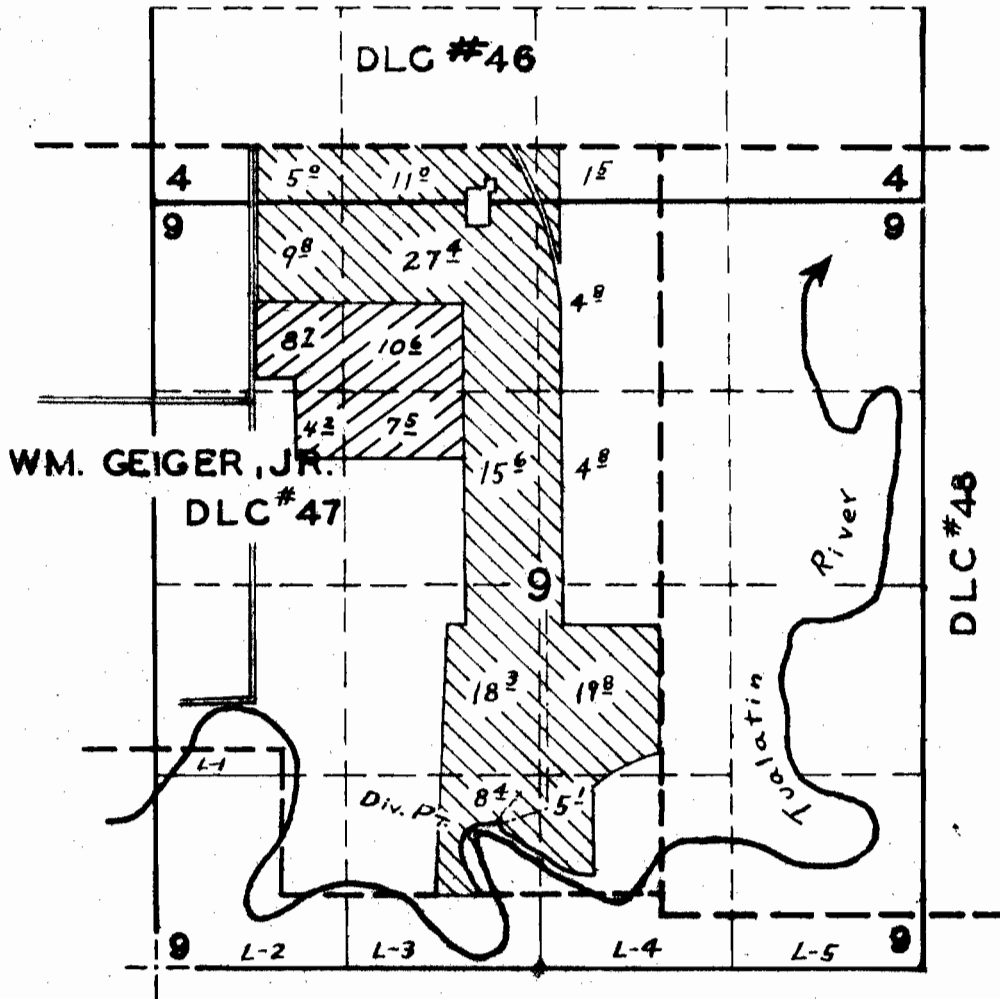

/// APPL. No 32906 ← file
PER. No. 26116

FINAL PROOF SURVEY
UNDER

Application No. 24985 Permit No. 19611
IN NAME OF

DAVID SAUCY, JR. & JEANNETTE O. SAUCY

Surveyed 5-3 1956, by R. WHITBY