


T.33S.R.2E.W.M.

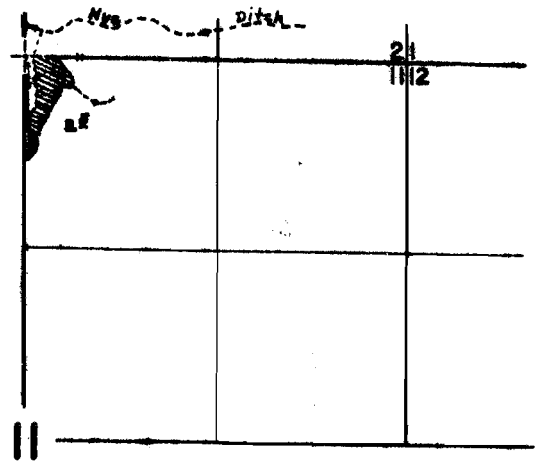

FINAL PROOF SURVEY UNDER

Transfer No. N-26

Application No. _____ Permit No. 14200

IN NAME OF

David Neville

Surveyed March 9, 1968, by D. G. Hendrix