


T.I.S.R. 2 W.W.M.

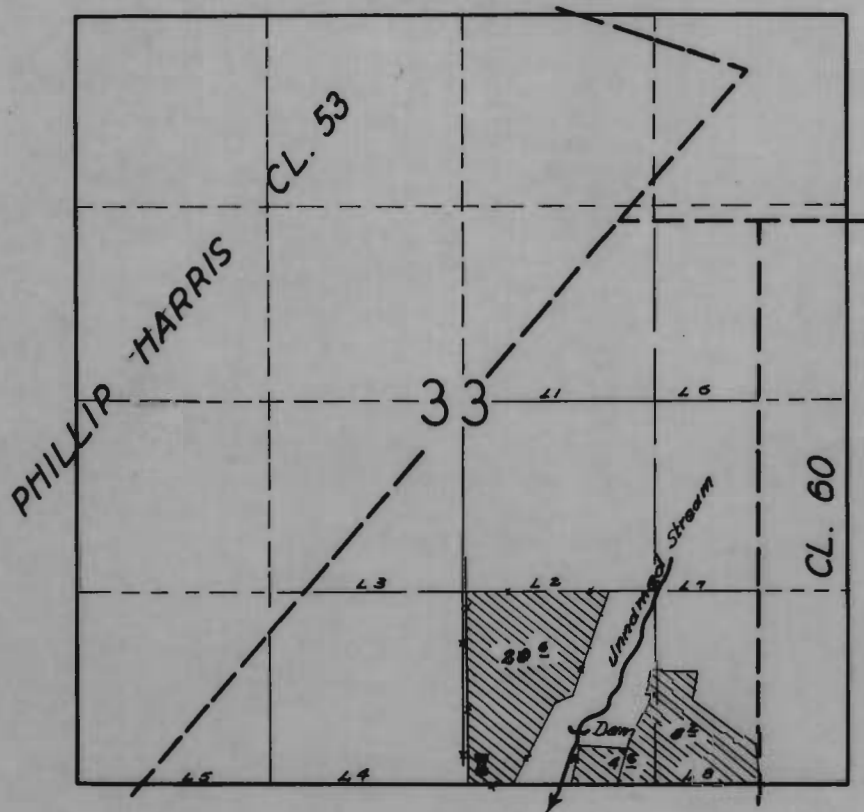

**FINAL PROOF SURVEY**

UNDER

Application No. 23602 Permit No. 18611

IN NAME OF

W. A. Prier

Surveyed 5 / 6 1952, by H. L. COFFMAN