


T.3S.R.IE.W.M.

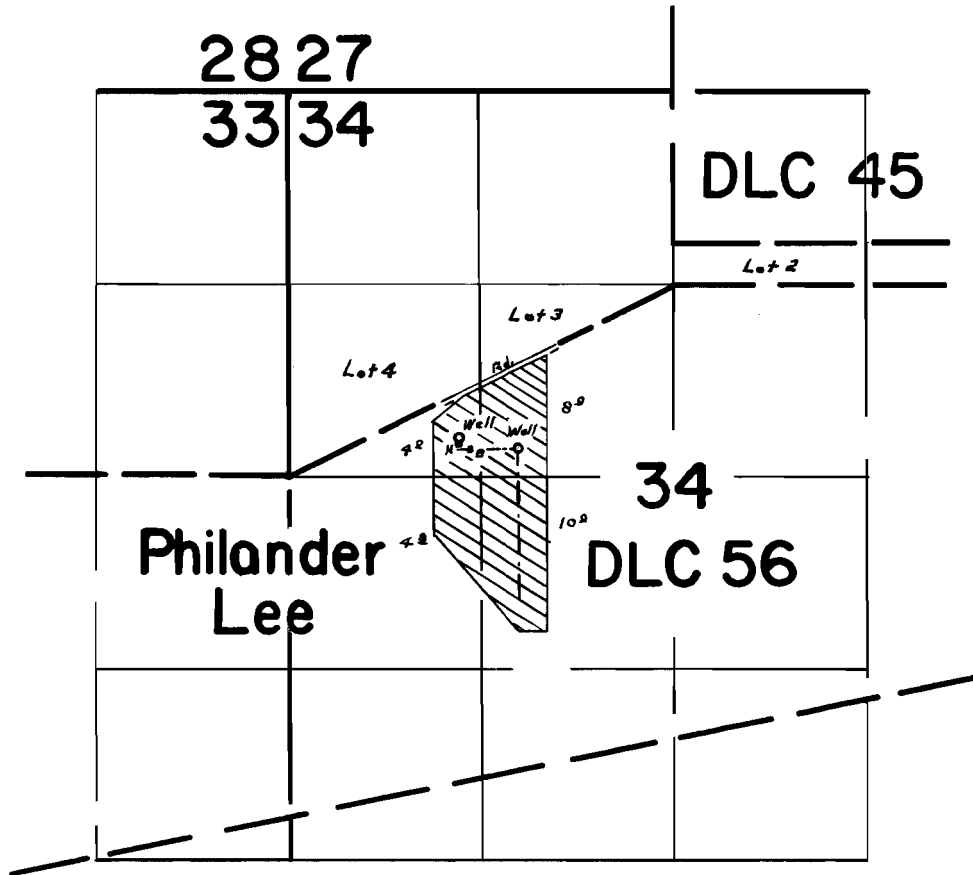

FINAL PROOF SURVEY  
UNDER

Application No. G-1302 Permit No. G-1186  
IN NAME OF

Ivan Arneson

Surveyed March 20 + 21 1962, by T.R. Lauer