


T.5S.R.1E.W.M.

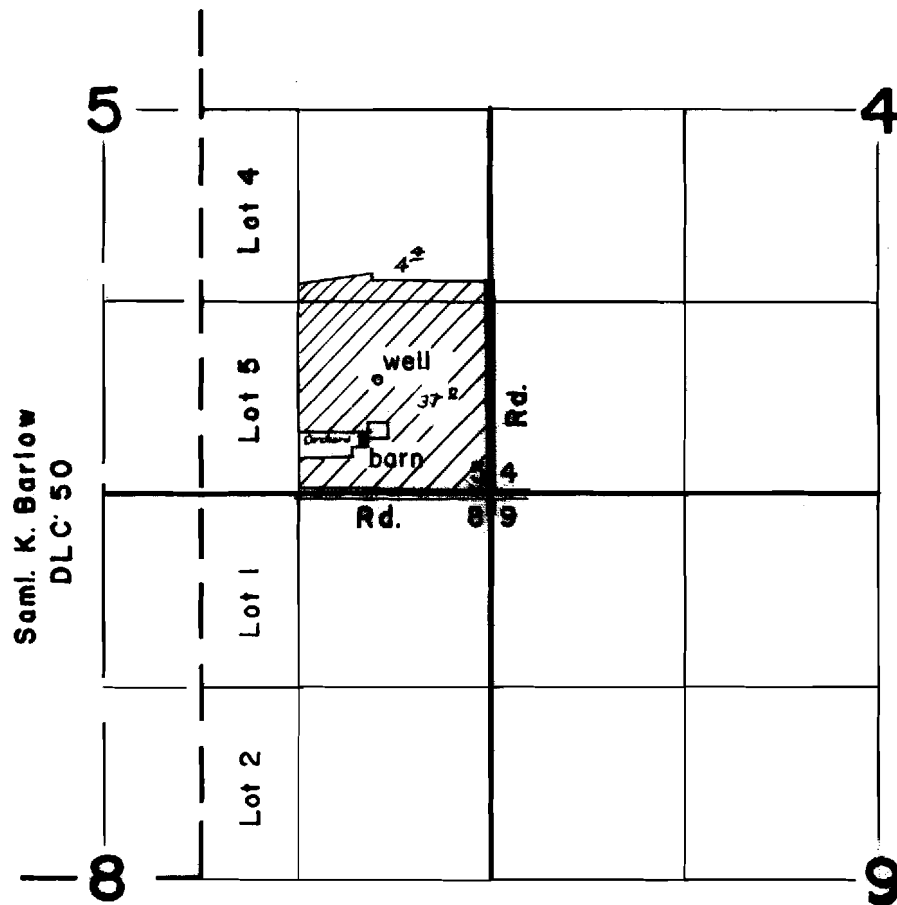

FINAL PROOF SURVEY
UNDER

Application No. G-1472.. Permit No. G-1351...
IN NAME OF

..... Alvin D. Rogle

Surveyed *March 20 1962*, by *C.P. Baker*.....