



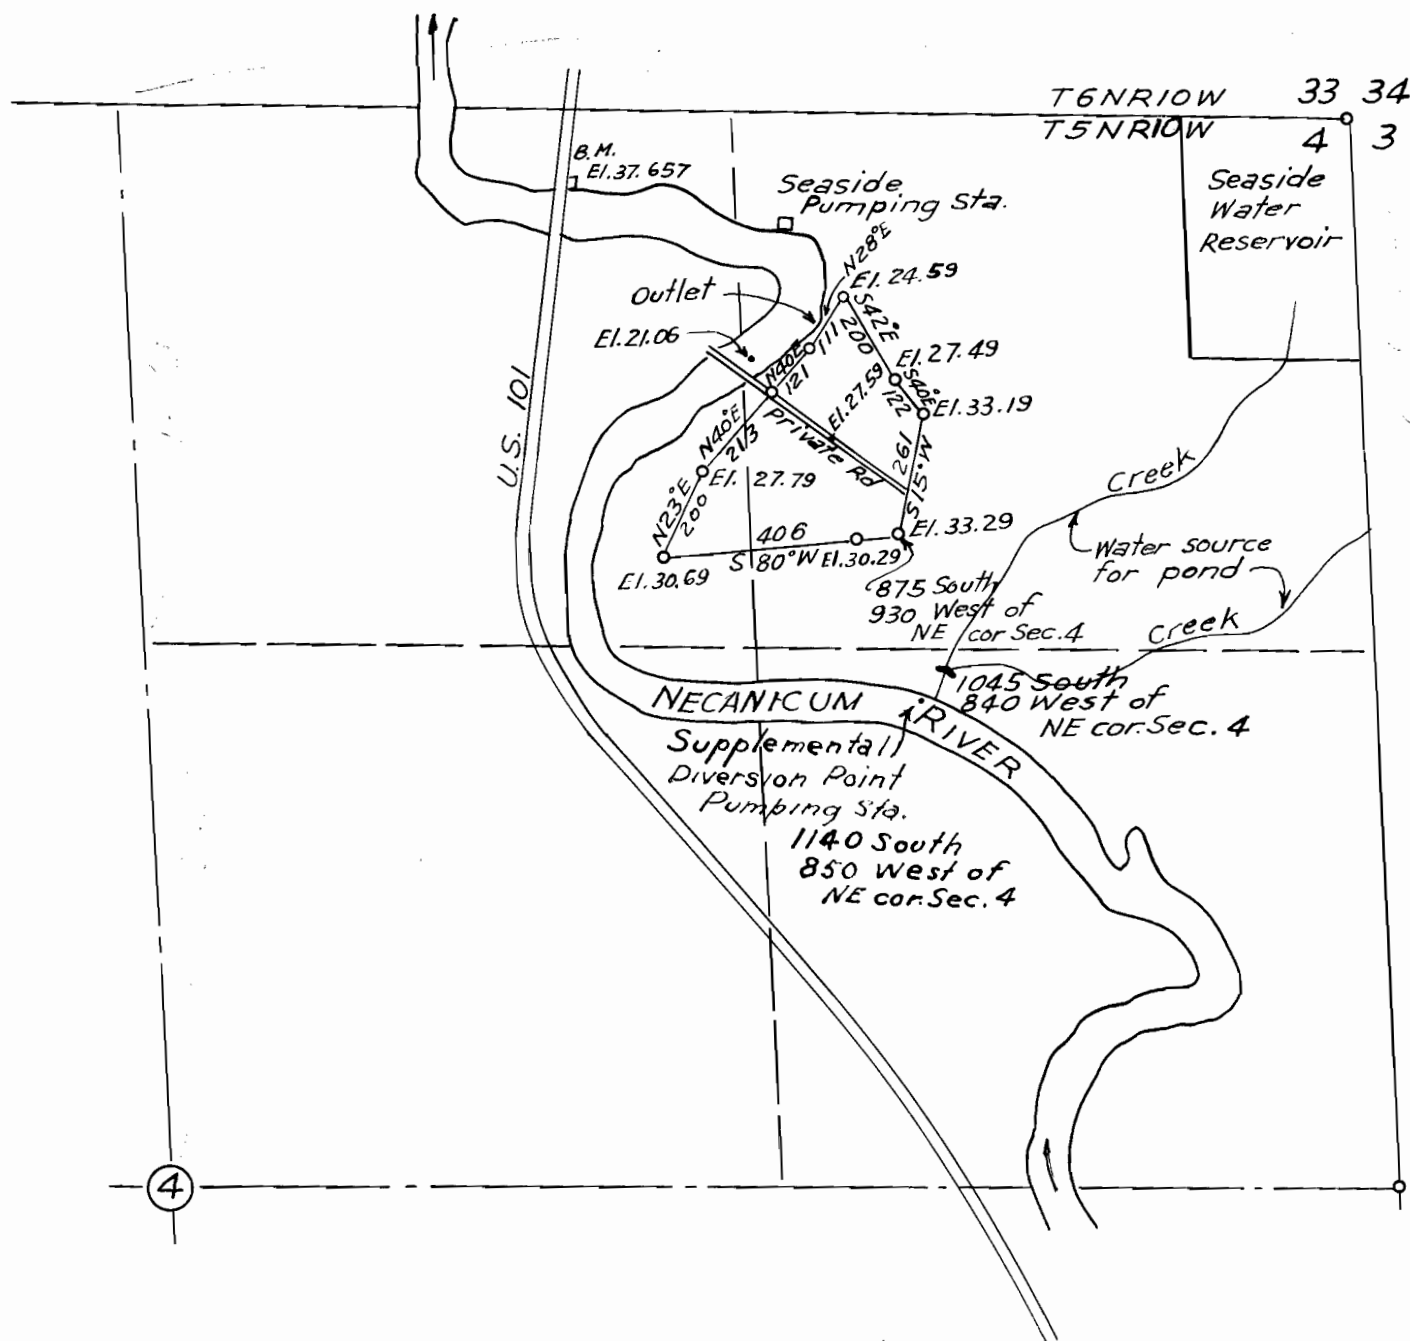

Dike elevation 32.0
Bottom pond elev. 24.0

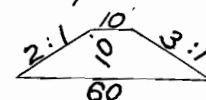

Typical dike section

Application No. R-32204 + 32205
Permit No. R-2128 + 6547

Vernon J. Davis