


T.38S.R.7W.W.M.

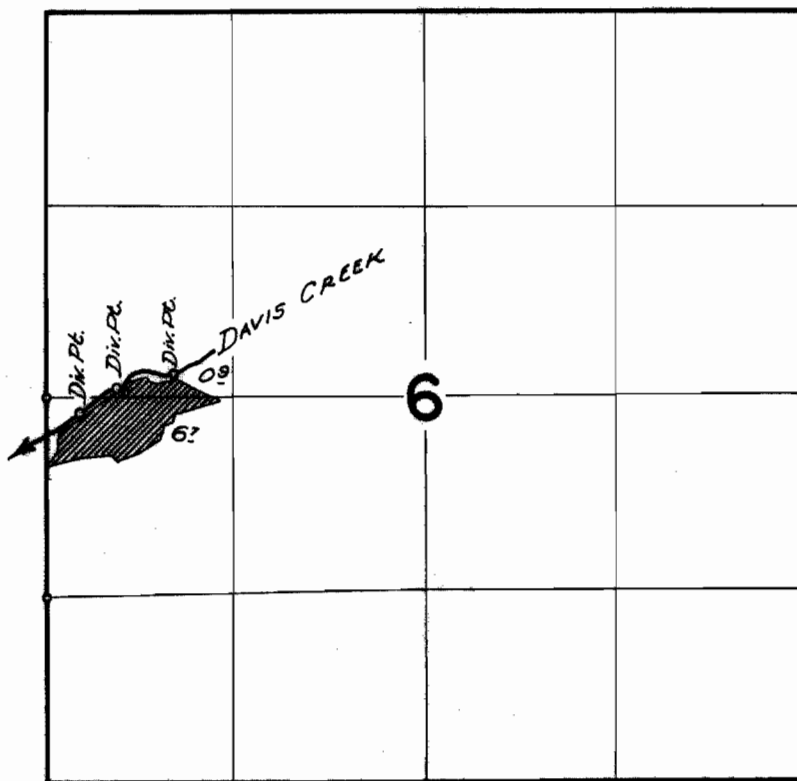

FINAL PROOF SURVEY
UNDER

Application No. 33952 Permit No. 29765
IN NAME OF

ARTHUR A. & RUTH O. WHITESELL

Sept. 28 1960 R. Steimer
Surveyed April 20 1961, by C.O. Bartala