


T. 10 S. W. M.

H. R. Oglesby

N

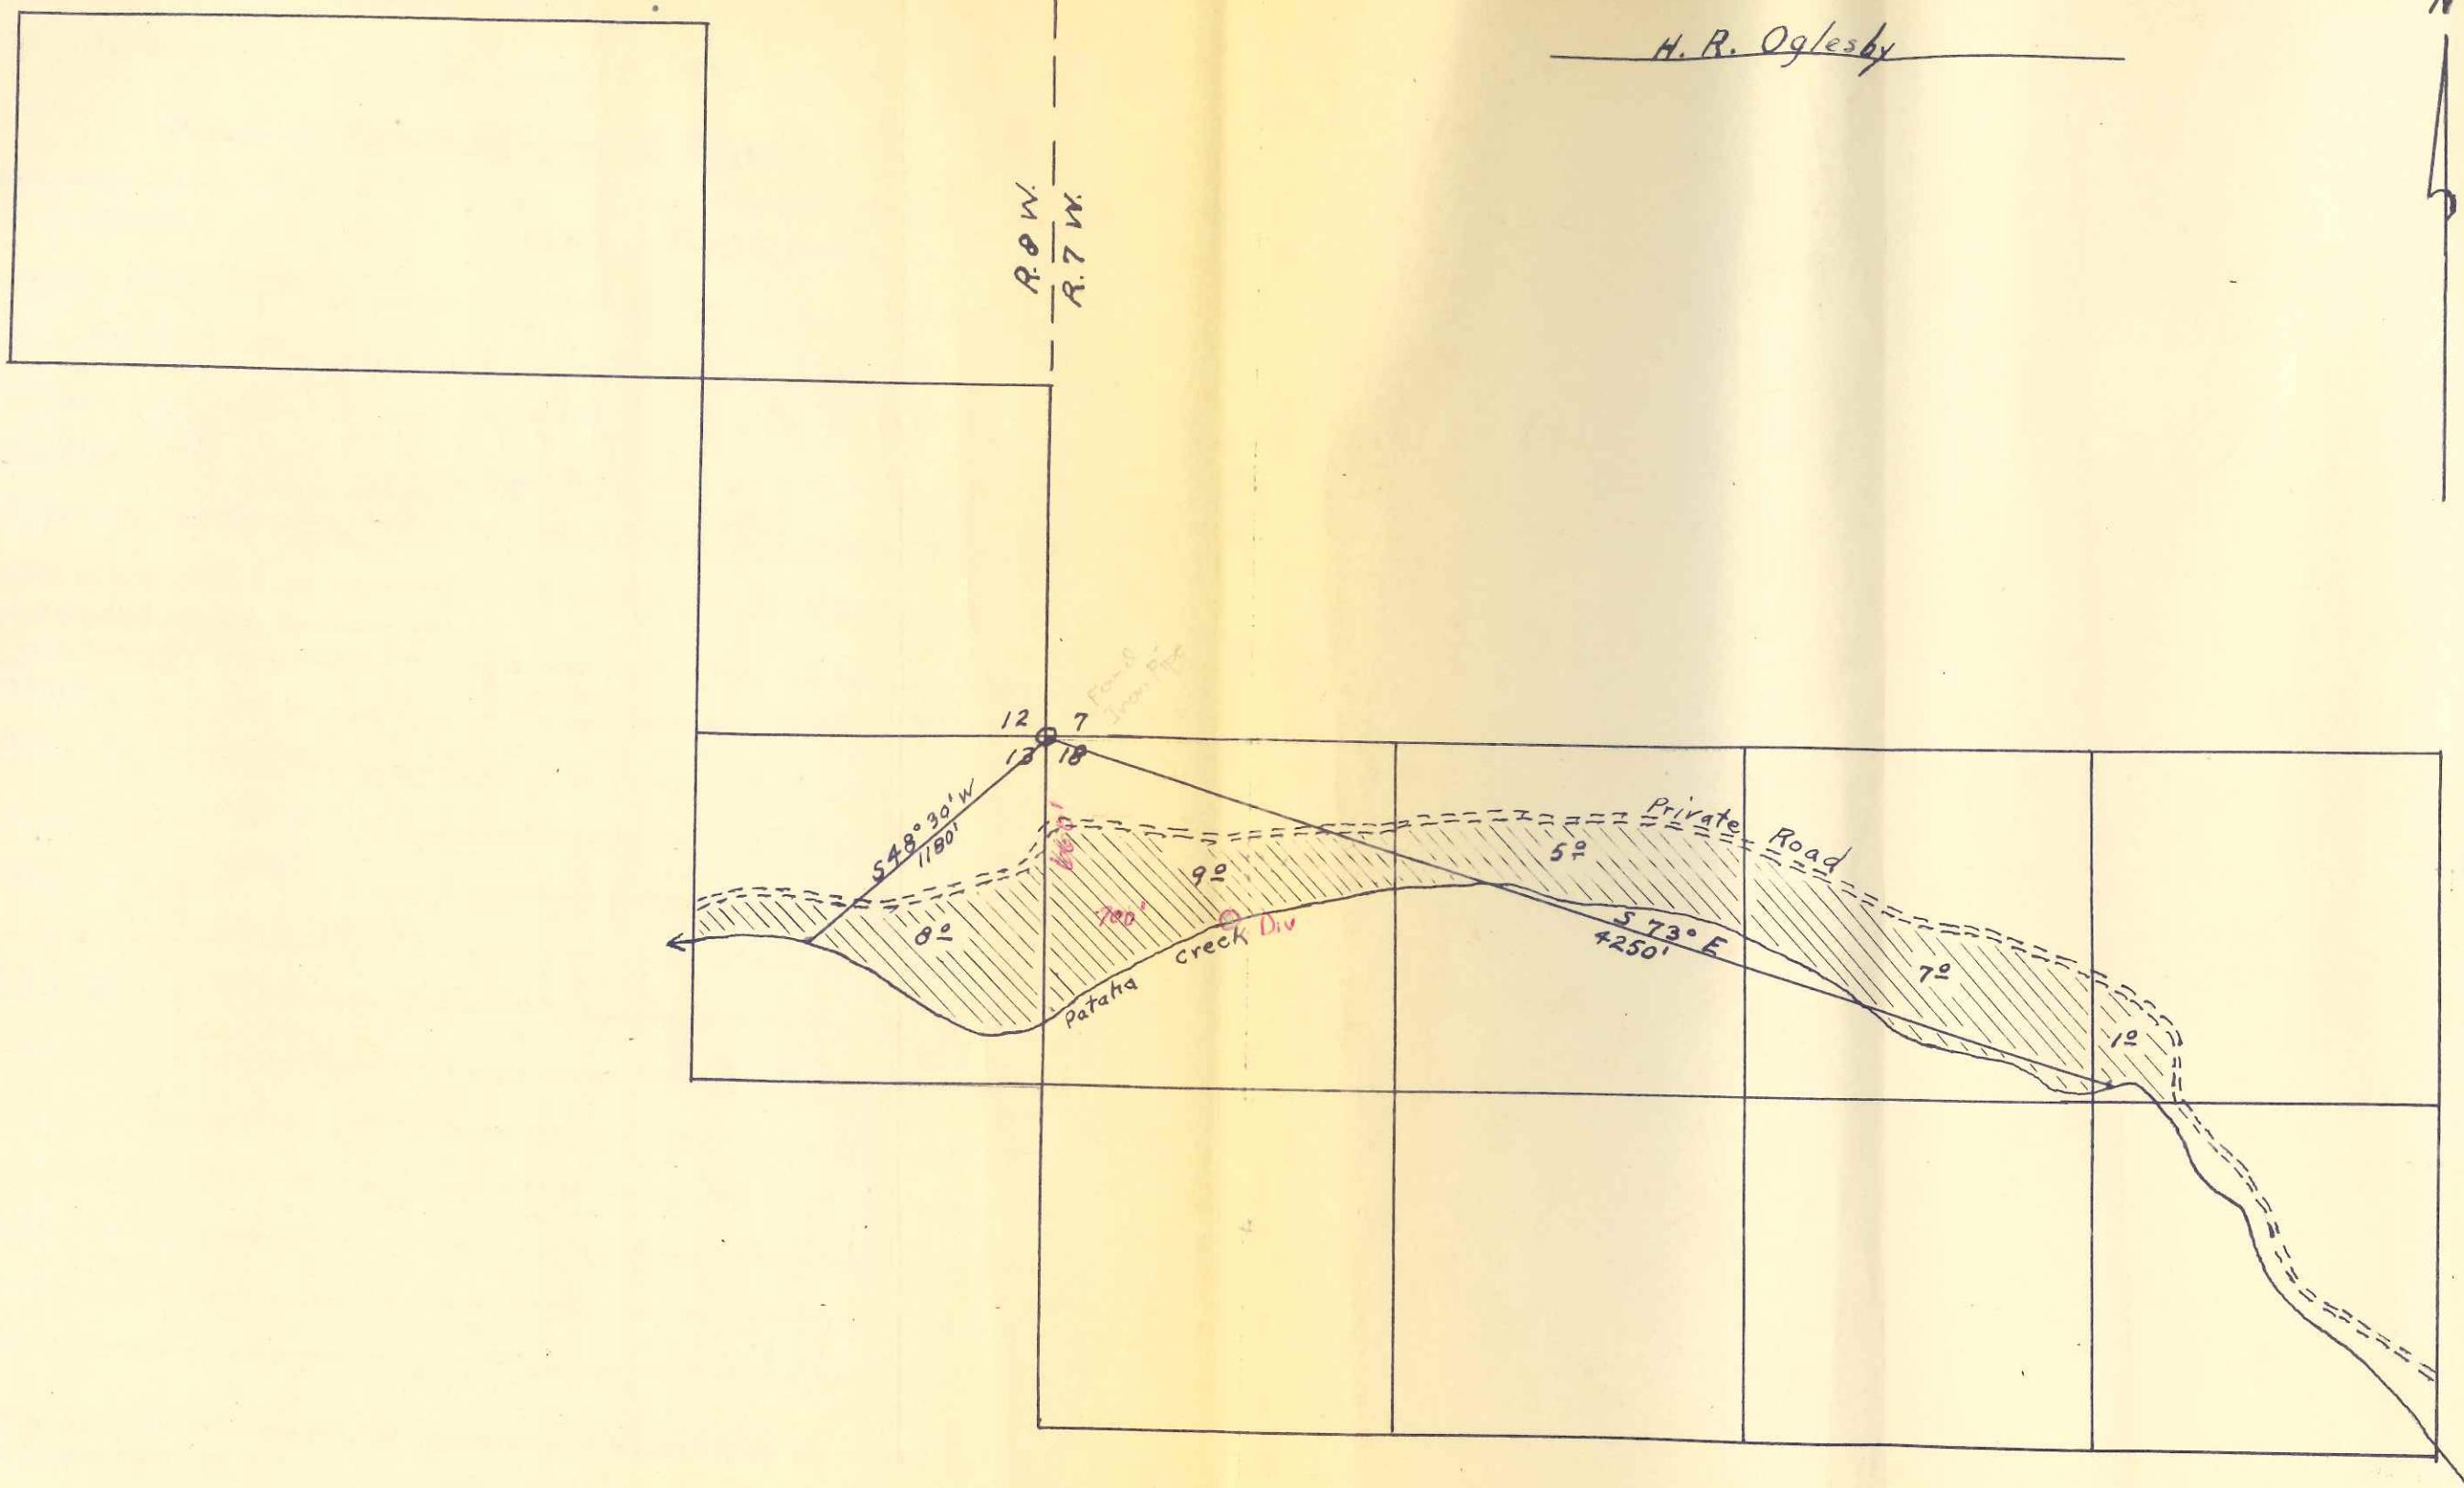

Scale : 1" = 660'
8" = 1 mile

Application No. 31483
Permit No. 24818