


T. 11 S. R. 2 W. W. M.

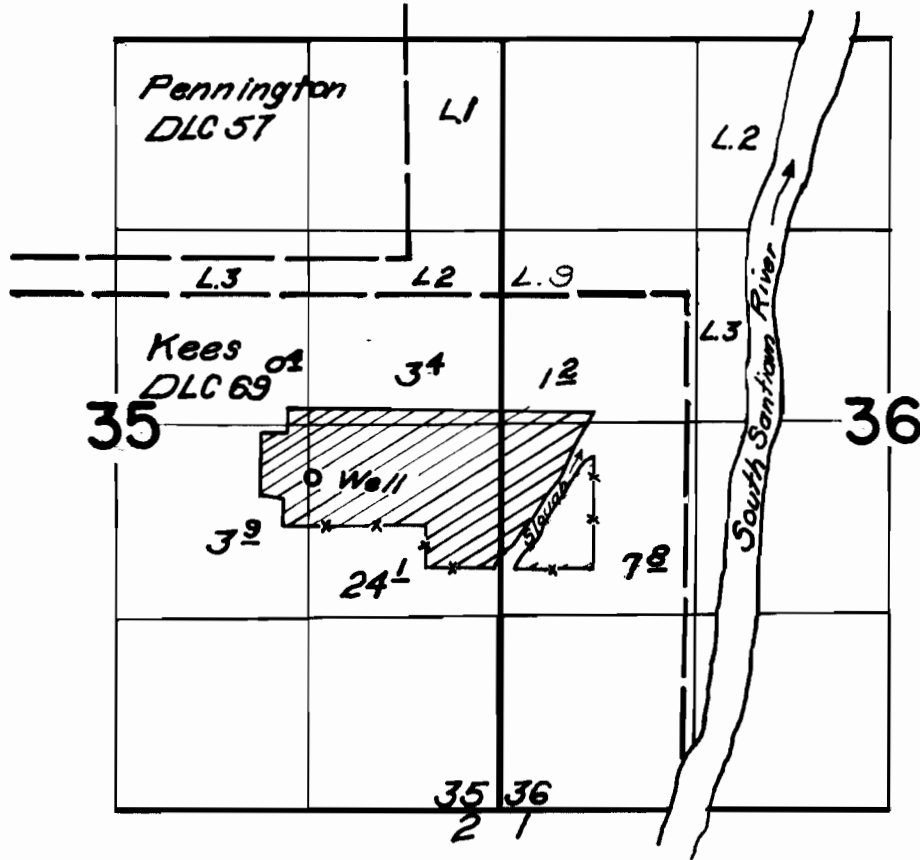

FINAL PROOF SURVEY UNDER

Application No. G-1260 Permit No. G-1083
IN NAME OF

D.G. Christenson

Surveyed Mar. 28 1962, by Carl R. Baker